

Renew Sec. Cor. 523 | 524
526 | 525 T265 R2W

Fd. 1916 G.L.O. BRASS cap firmly set
& MKd. " T265 R2W 523 | 524 " & O.B.T.s -
526 | 525

ORIG. 36" Now 48' F. R. N. 50° E. 26 1/2 FT.
Blive - shows good scar - we Rescribe
" T265 R2W 524 CS BT " IN BARK.

ORIG. 8" Now 11" Chingapin N. 20° W. 13 1/2 FT.
Now 5 1/2" 29. Shows "65 23" scribe on open Blive

SW. O.B.T. gone & S.E. O.B.T. Burned stub.
MARK New B.T.s -

18" cedar S. 5° E. 9 1/2 FT.

Mkd. " T265 R2W 525 CS BT "

1" Pine snag. N. 56° W. 7 1/2 FT.

Mkd. " T265 R2W 523 CS BT "


No trees or stumps to S.W.

This cor. lies on E. edge of
old log road near landing.

Sec's 23, 24 & 26 logged off many
years ago.

August 21, 1967

V.R.T.
J.H.
D.W.

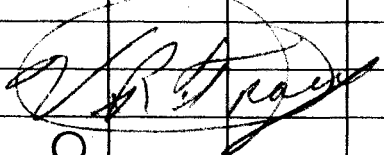

#1 O.K. J.W.D.

G.S. File No. 53/14-70