


Fd. 27-2

S. $\frac{1}{4}$ S 12

UNRECORDED

we find US. Plywood
 Alum. Cap set from
 O.B.T.s - we find scribe
 on S.E. also new AT.
 12" Pine N. $17\frac{1}{2}^{\circ}$ E. 25⁸ Ft
 scribe visible on nearly
 healed blaze. From
 This cor. we find
 US. Plywood Alum cap
 MKd $\frac{13}{13}$ only NO B.T.s
 Fd. - see Illustration
 Below

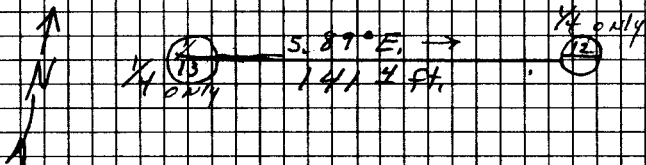

DIETZGEN NO. 388-6

CS 54/40-109

D.K. J.W.B.