
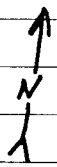


Renew Closing Cor. 516/515 T275 R2W
 Fd. 1 1/2" I.P. with 1" piped us. Ply
 Alum. Cap See Reel #50

FOBT. as follows -
 7" now 16" cedar S. 55° W. 33° ft.
 Now 5' 29" - scribe visible on previously
 opened Bl 20 - SH 4415 B.T. to S.E.
 also 5' 29" WEMK. New B.T.S -
 10" D. FIR S. 12° W. 4 1/3 ft.
 MKd. "T275 R2W 516 CC CS BT"
 13" D. FIR S. 61° E. 17° ft.
 MKd. "T275 R2W 515 CC CS BT"

This cor. lies on moderate
 Northerly slope. (See Illustration
 Below)

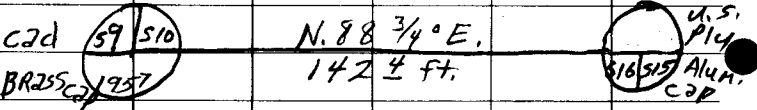

Dec. 11, 1968

V.R.T.
 F.W.J.
 U.P.

V.R. Tracy

O.V.
 J. W. M.

○
 #121

C. S. File No. 54/40-153