

N62°19'15"W 135.00'

S62°15'15"E 300' MONUMENT


N62°15'15"W 303' MONUMENT

STEPHENS STREET

S27°27'25"W 130.00'

N27°27'25"E 130.00'

MAP SHOWING LOCATION OF MONUMENTS U.S. POST OFFICE ROSEBURG, OREGON. Scale 1 in. = 8 ft.

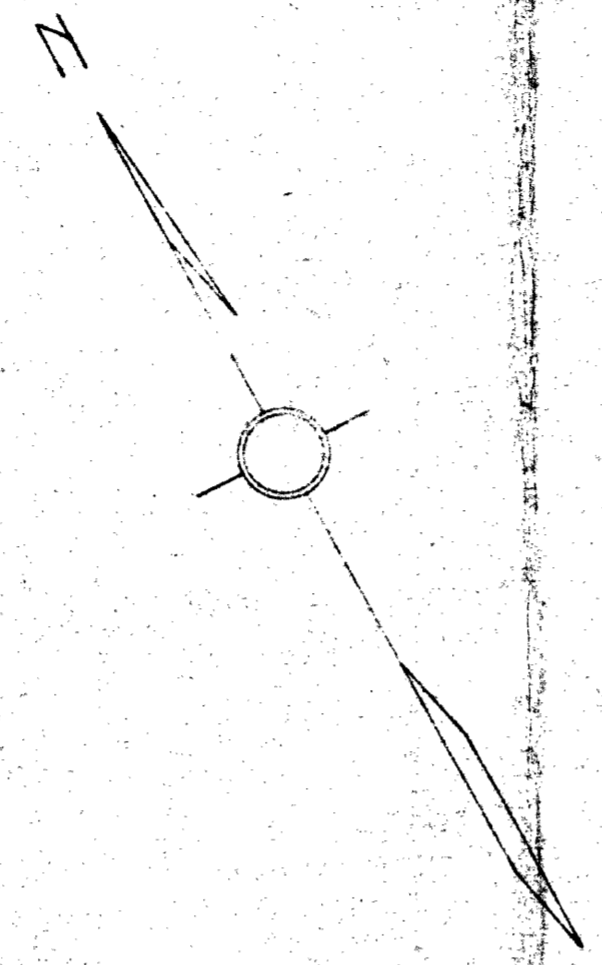


ENGINEER'S CERTIFICATE.

I, hereby certify, that on the 22nd. day of August, A.D. 1917, I set the monuments as shown on the accompanying plat, and do further certify that the courses and distances as shown thereto, and the description of said monuments, are correct.

R. H. Fleener
Engineer.

DETAIL OF MONUMENT.

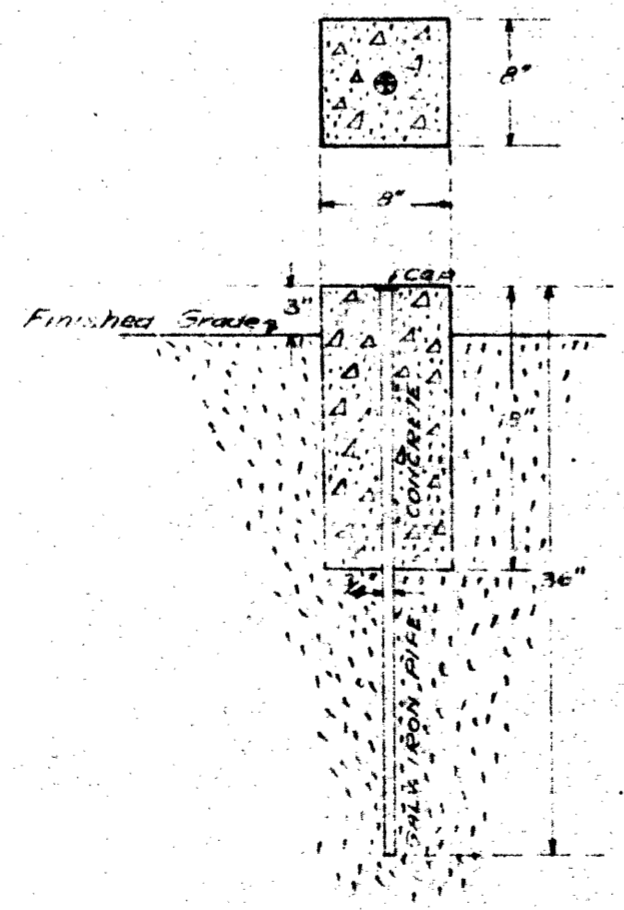

S27°27'25"W 300' MONUMENT

S62°19'15"E 135.00'

MONUMENT S62°15'15"E 300'

CASS STREET