


**COUNTY SURVEYORS USE DATA  
DO NOT REMOVE FROM OFFICE**

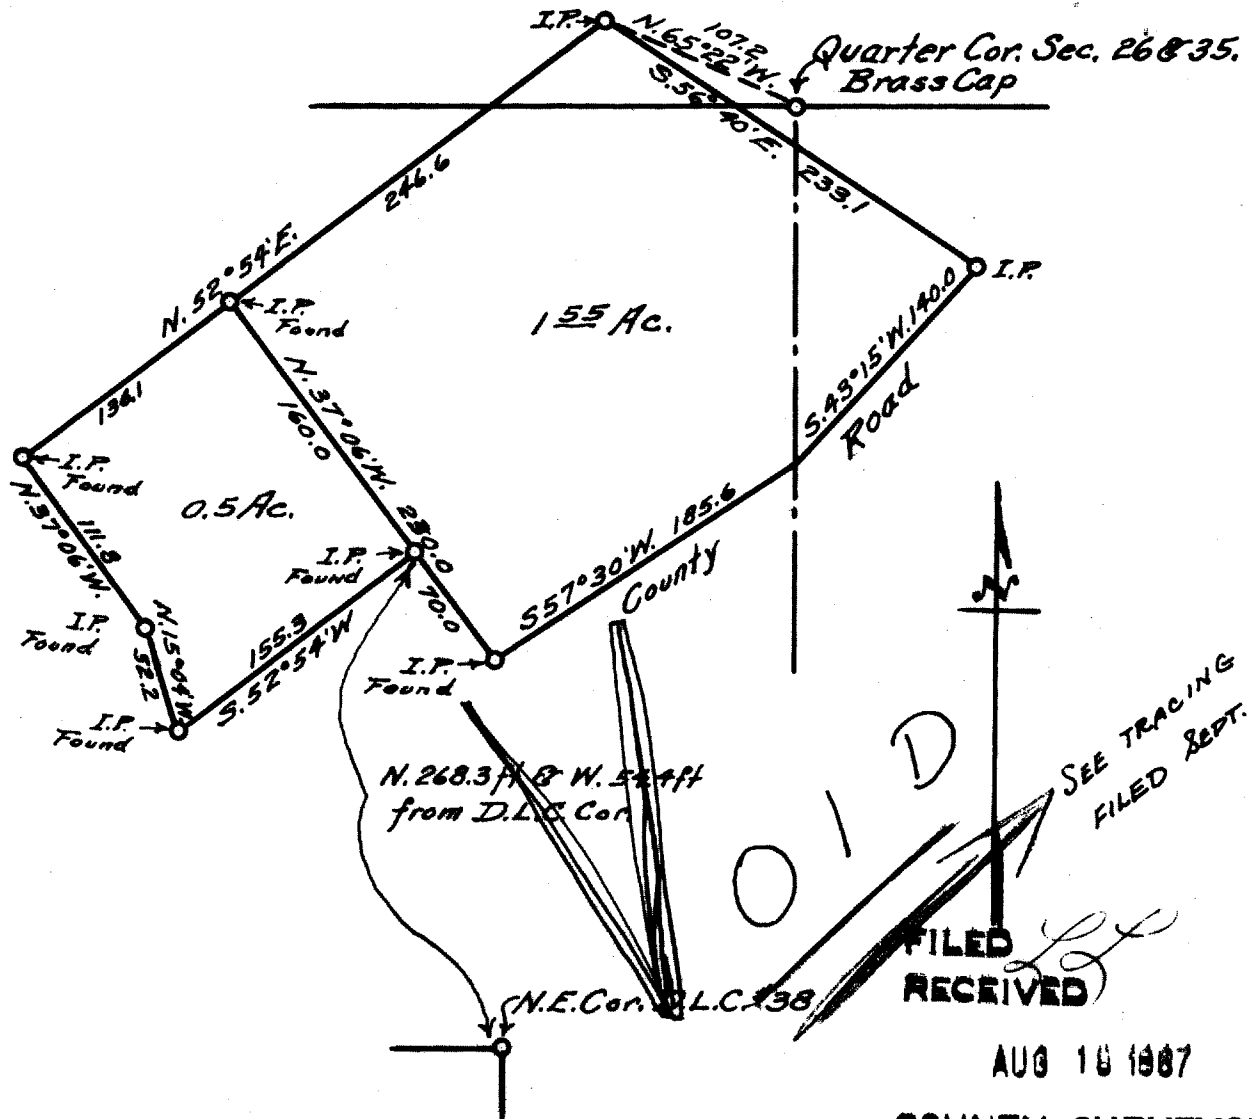

SEE TRACING  
FILED SEPT. 1967

FILED  
RECEIVED

AUG 16 1967

COUNTY SURVEYOR  
DOUGLAS COUNTY, ORE

COUNTY SURVEYOR'S OFFICE  
DOUGLAS COUNTY, OREGON.

SURVEY FOR  
Mrs. C.E. Young, IN  
Sections 26 & 35, T. 32 S., R. 6 W., W.M.  
Geo. J. Wenderoth, Deputy. August 1967  
Scale 1"=100ft.

REGISTERED  
OREGON  
LAND SURVEYOR

Geo. J. Wenderoth

MARCH 10, 1941  
George J. Wenderoth  
5