

Renewal $\frac{1}{4}$ S21 only | T315 RIW

Found: BRASS CAP and 3 BTS

~~22~~ $\frac{1}{4}$ 34" D FIR now 44" SIDE 15⁰ FT OBT
Shows a good face. Note: This BT
is referred, as a BT to the $\frac{1}{4}$ COR of
S22 only by GLO field notes.

$\frac{1}{4}$ 34" D FIR now 39" NS4W 38⁰ FT OBT
Shows a good face

20" D FIR now 26" S68W 23⁵ FT
Opened and found scribbling of '4522 BT

NOTE: This BT is the same as
the rest of the BTS. BUT IT IS NOT
RECORDED IN THE GLO FIELD NOTES.

NOTE: I've found the BRASS CAP
FOR $\frac{1}{4}$ OF S22 ONLY IN PLACE OF
THE $\frac{1}{4}$ OF S21 ONLY. we switch

THE BRASS CAPS AROUND SO THEY
ARE IN THE RIGHT PLACES. now reads
as follows: RESET GLO BRASS CAP
AT THE $\frac{1}{4}$ COR OF S21 ONLY. M.K.D.

U. S. GENERAL LAND OFFICE SURVEY

$\frac{1}{4}$ S21

19 22

OVER

O. K.

#128

J. W. B.
C. S. File No. 54/21-68

DIETZGEN NO. 3885'S

Rescribed BT.

26' DFIR S68W 23⁵ FT

scribed V4 S21 CS BT


NOTE This $\frac{1}{4}$ COR OF S21 ONLY

LIES 7.9 FT NORTH OF THE

$\frac{1}{4}$ COR OF S22 ONLY.

NOTE:

These caps were orig. Placed
in the wrong location & Facing
South. We dig them up and
replace them in the right
places facing north. The
caps now refer to the
right sections.

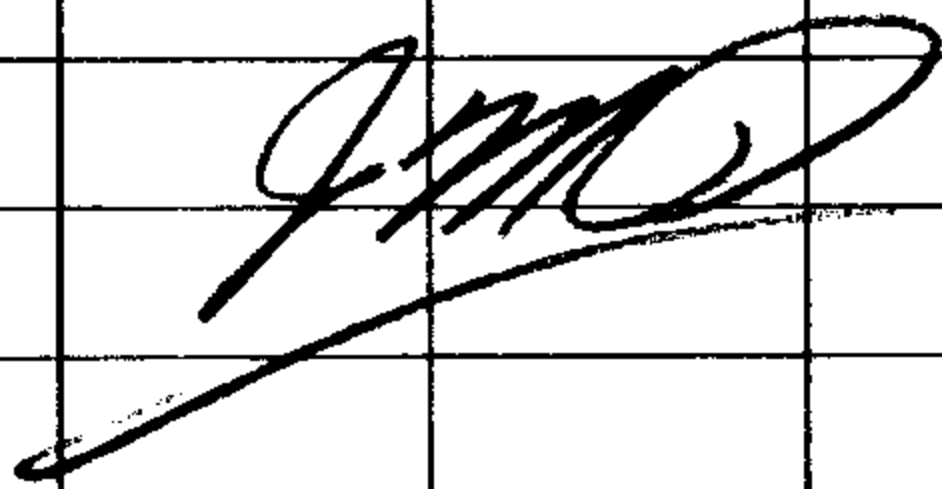

O.K. J.W.B.