


Fd. $N\frac{1}{4}$ 56 UNRECORDED 32" cedar snag facing N. 50° to 60° W. with old scribe " $\frac{1}{4}$ 56 BT" "W" nail & Tag
 Near Base of Tree - we find NO Trace of orig Hemlock BT. - By measuring $\frac{1}{2}$ chain or 33' west FROM creek - we find The cedar faces this point - also a 30" maple bears N. 20° E. 24' ft 25 in
 The fieldnotes - But the center of this tree is decayed out for more than the orig. 6" size. This point is 20' south of Weyerhaeuser's Line that is MKd. "TRUE LINE" - Weyerhaeuser's Proportioned $N\frac{1}{4}$ cor. of Sec 6 Bears N. 76° W. 84' ft.

(see Rev. #30) FROM same point,

we set temporary post from 30" maple - The 32" cedar bears $S58^{\circ}E$. 19' ft. (see Illustration

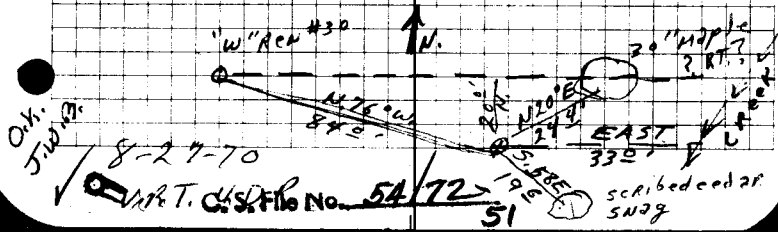

DIETZGEN NO. 385-5