

54/88-1

MARCH 18, 1944
George J. Wenderoth
5

Geo. J. Wenderoth
REGISTERED
OREGON
LAND SURVEYOR

COUNTY SURVEYOR'S OFFICE
DOUGLAS COUNTY, OREGON.
SURVEY FOR
E. J. BUNCH, IN
SECTION 22, T. 32S, R. 5W, M.M.
Geo. J. Wenderoth, DEPUTY, MAY 1969
Scale 1" = 50 ft.


PROPERTY BOUNDARIES SET DATA
ON NEW TRIANGULAR TRIPLE WIRE

1/2 I. Pipe North 13925 and West 8083
from Corner Sections 22-23-26 & 27.

COUNTY SURVEYOR
DOUGLAS COUNTY, ORE.

MAY 19 1969

FILED
RECEIVED

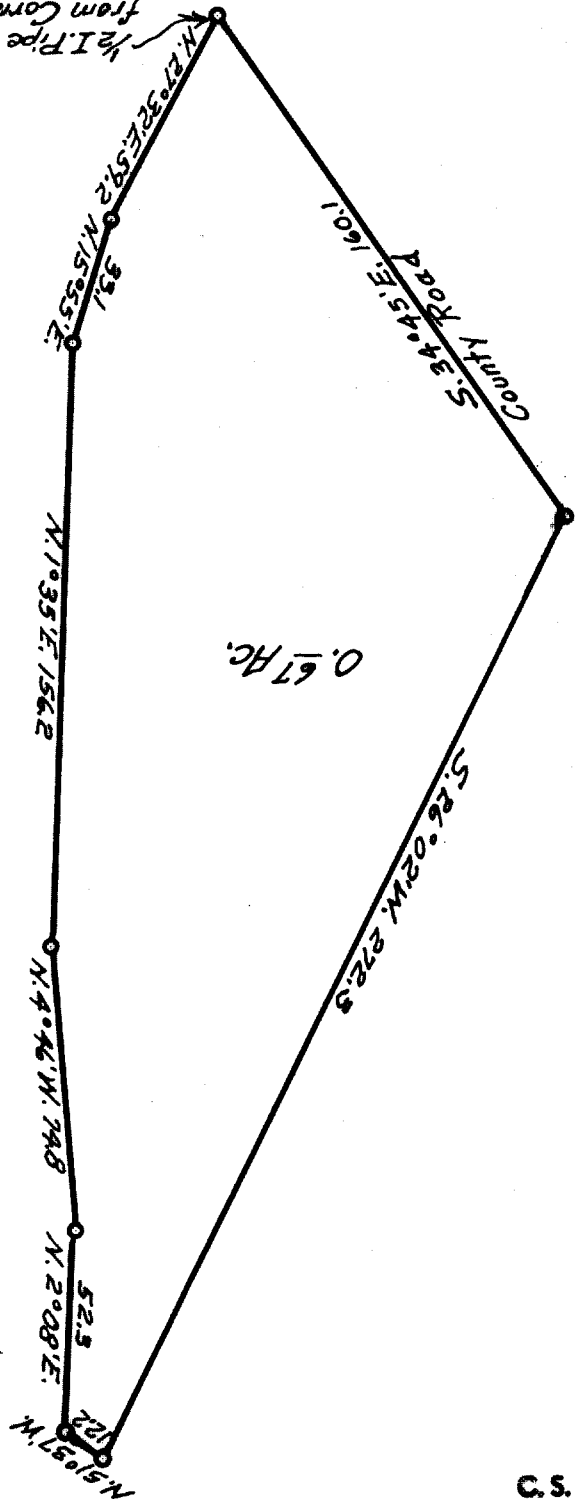

C. S. File No. 54/88-1