


FILED  
RECEIVED  
SEP 16 1969  
COUNTY SURVEYOR  
DOUGLAS COUNTY, ORE.

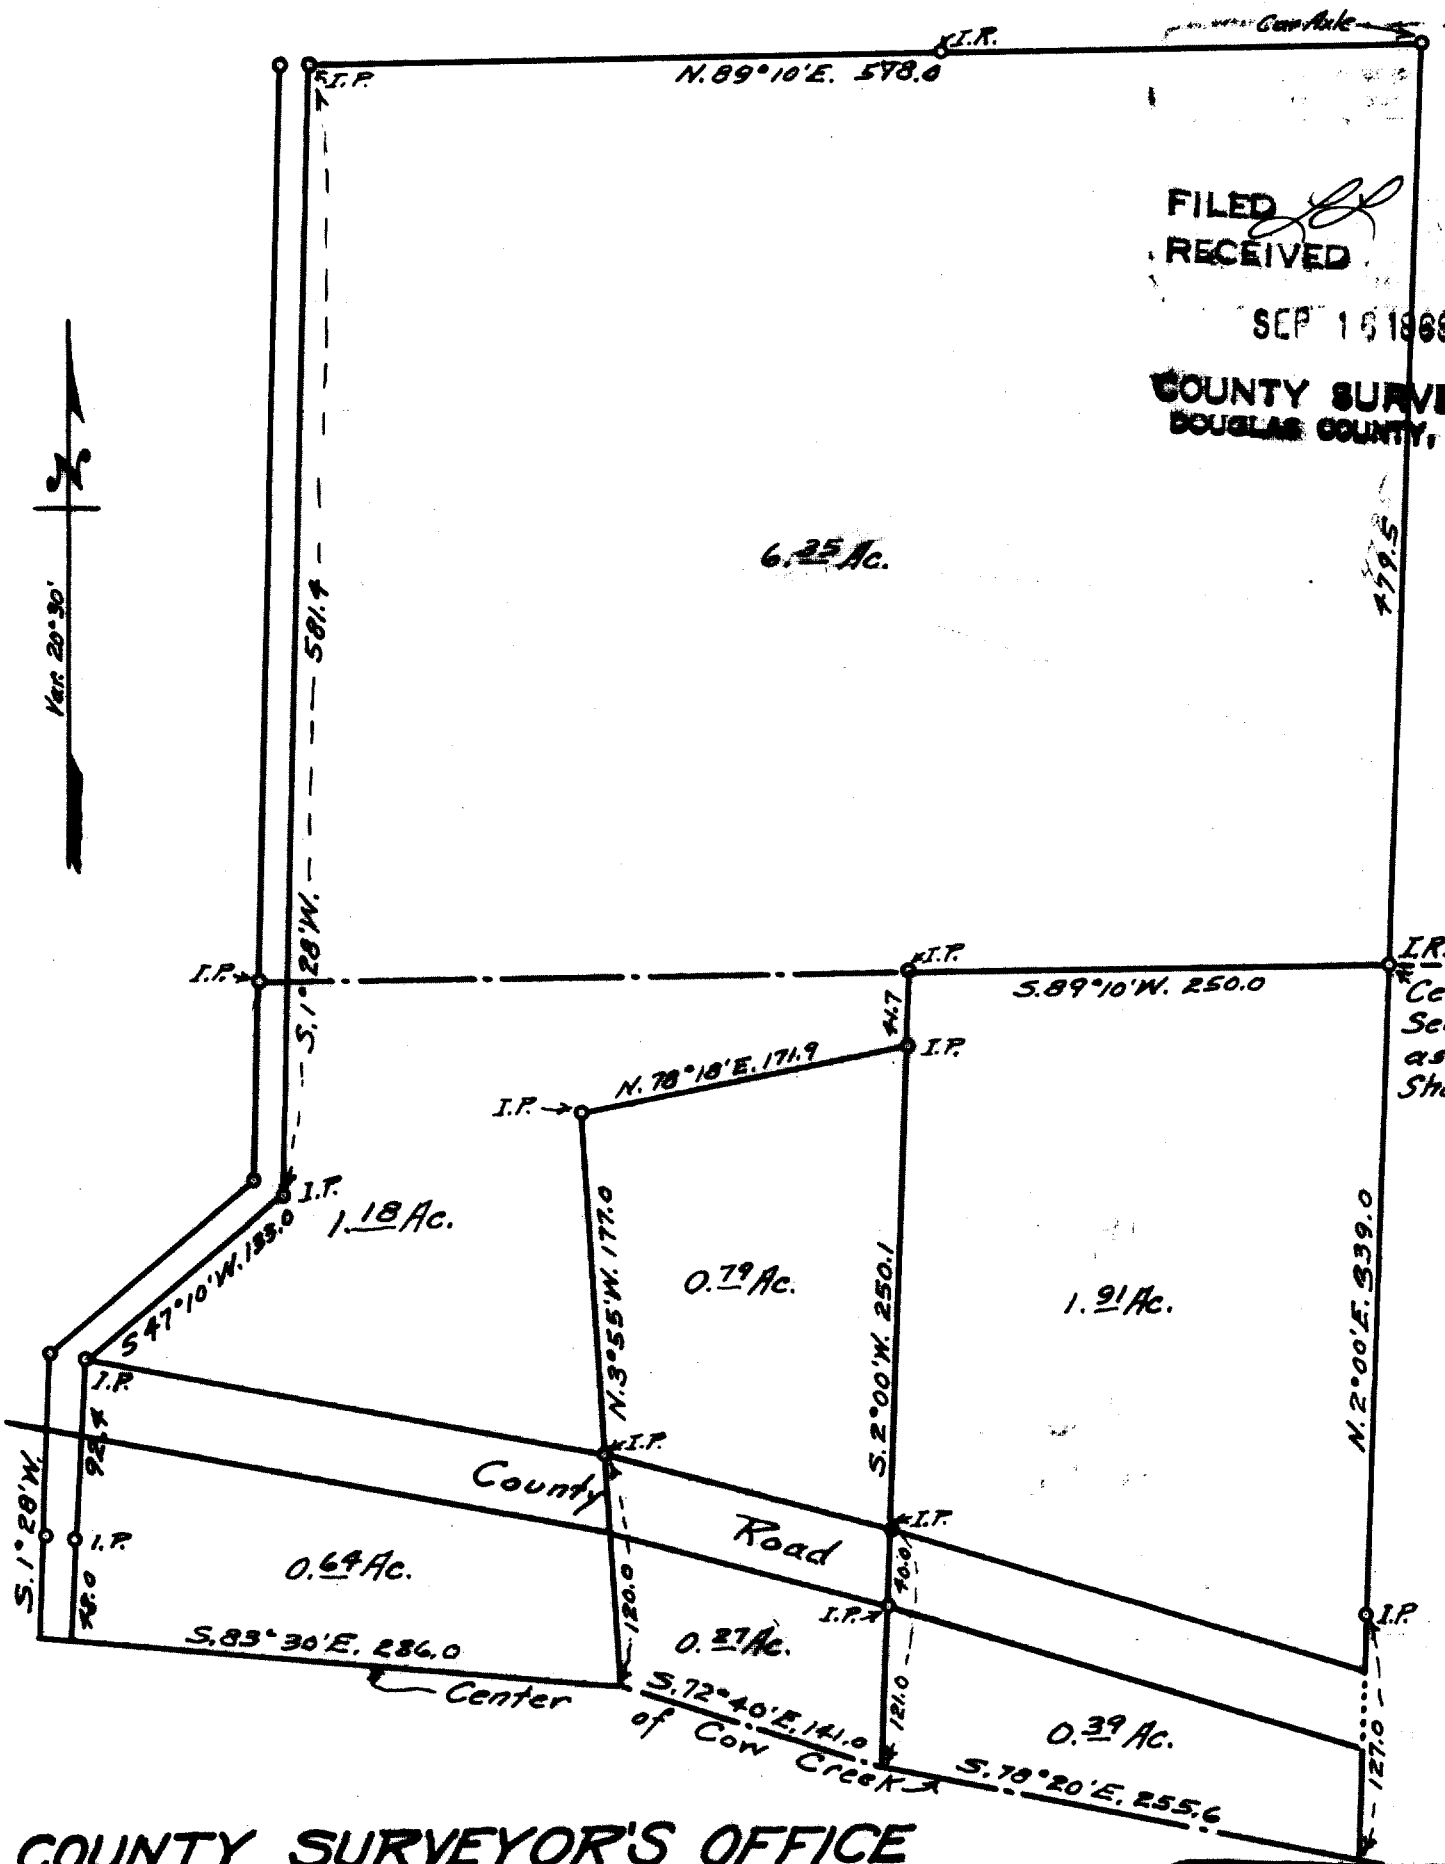

COUNTY SURVEYOR'S OFFICE  
DOUGLAS COUNTY, OREGON

SURVEY FOR  
MRS. LEONARD SELL IN SEC. 5, T. 32 S., R. 4 W. W.M.  
GEO. J. WENDEROTH, DEPUTY. SEPT. 1969

SCALE 1" = 100 ft.

COUNTY SURVEYOR'S OFFICE DATA  
DO NOT REMOVE FROM OFFICE

REGISTERED  
OREGON  
LAND SURVEYOR

Geo. J. Wenderoth

MARCH 16, 1964  
George J. Wenderoth  
5