


SET REFERENCE HUBS

FBR 1/4 COR. S1 T32 SR3W
312

Pen. #69

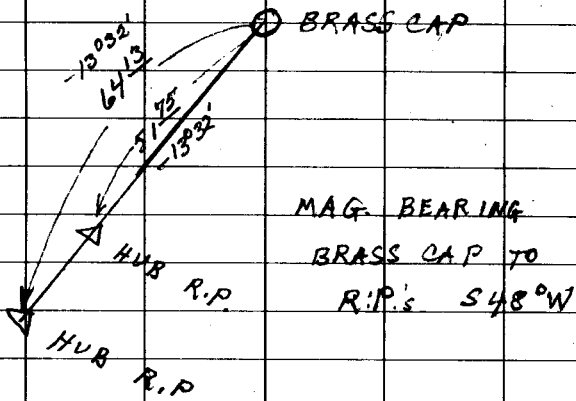

MAG. BEARING
BRASS CAP TO
R.P.'s S48°W

BRASS CAP REMOVED

TO BE REPLACED LATER

FROM R.P.'S MAY 6, 1964

Milo E. Godfrey

M.G.
W.S.
M.S.