


**SURVEYED FOR PROPERTY  
CORNER RESTORATION  
SEC. 21, T. 28 S., R. 6 W. W.M.  
SURVEYED FOR RON CAVIN  
SURVEY BY BAIGHMAN SURVEY  
CIVIL BEND ROAD SERVICE  
50' R/W**

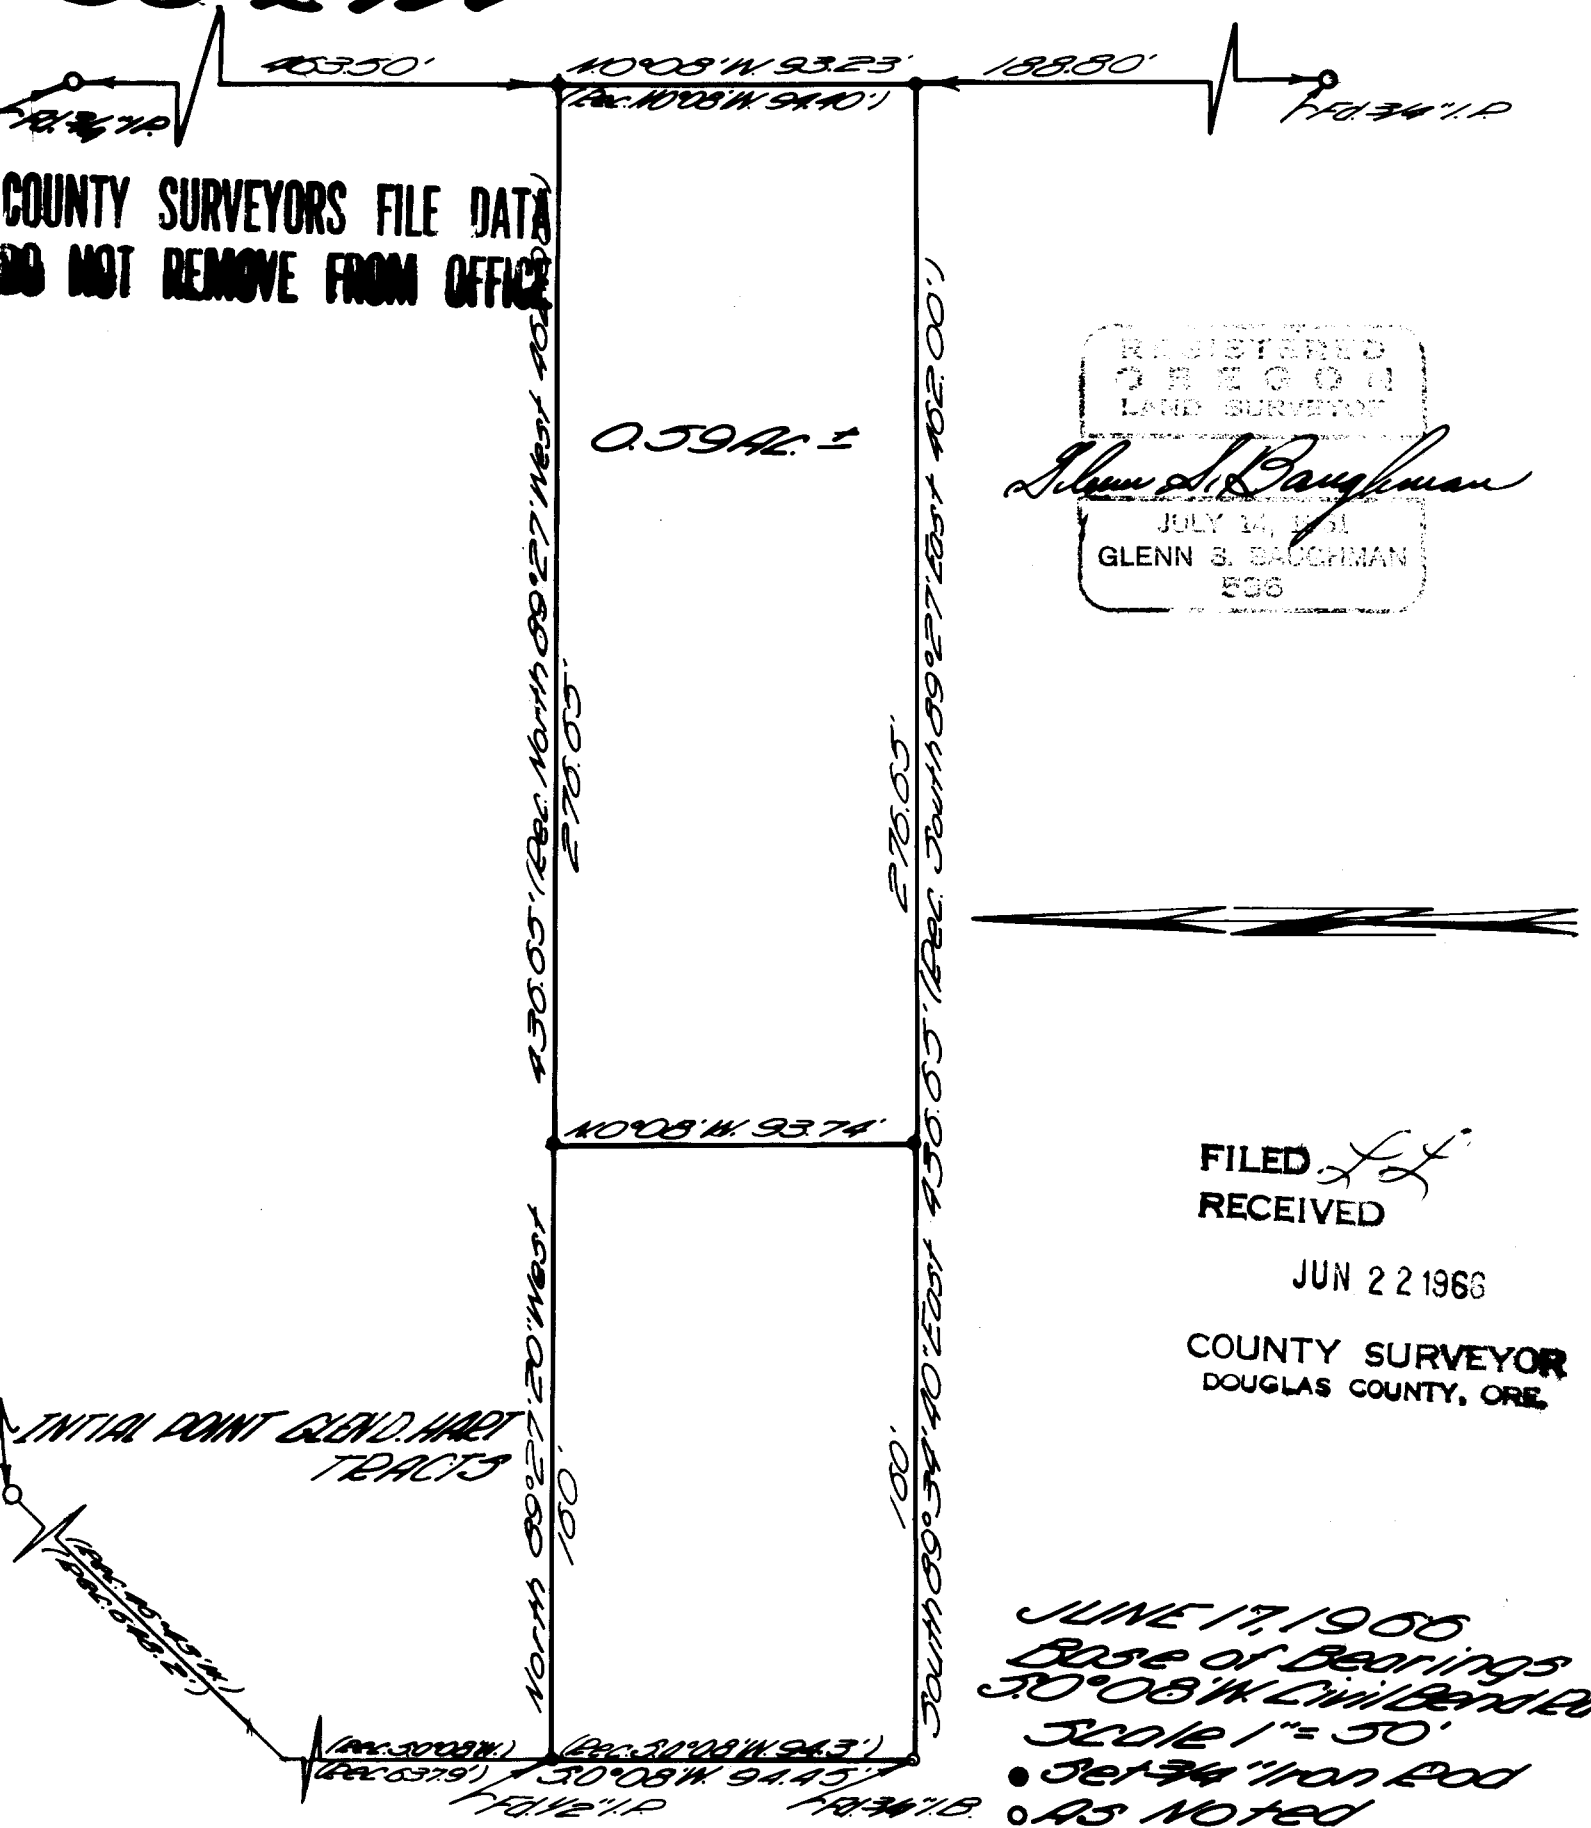

COUNTY SURVEYORS FILE DATA  
DO NOT REMOVE FROM OFFICE

REGISTERED  
OREGON  
LAND SURVEYOR  
*Glenn S. Baighman*  
JULY 14, 1961  
GLENN S. BAIGHMAN  
536

FILED *LL*  
RECEIVED  
JUN 22 1966  
COUNTY SURVEYOR  
DOUGLAS COUNTY, ORE.

JUNE 17, 1966  
Base of Bearings  
30°08' N Civil Bend Rd.  
Scale 1" = 50'  
• 3/4" Iron Rod  
• AS NOTED