

SURVEYED FOR PROPERTY COR.  
 RESTORATION; LOT #13 BLOCK  
 3 HAMILTON ADD. IN CITY OF ROSEBURG  
 SURVEYED FOR W.T. & J. DAWSON  
 SURVEY BY BAUGHMAN SURVEY SERVICE  
 SCALE 1" = 20' JUNE 28, 1966


COUNTY SURVEYORS FILE DATA  
 DO NOT REMOVE FROM OFFICE

REGISTERED  
 COUNTY OF CLATSOP  
 LAND SURVEYOR

*Glenn S. Baughman*

JULY 14, 1966  
 GLENN S. BAUGHMAN  
 536

• Set 3/4" Iron Rod

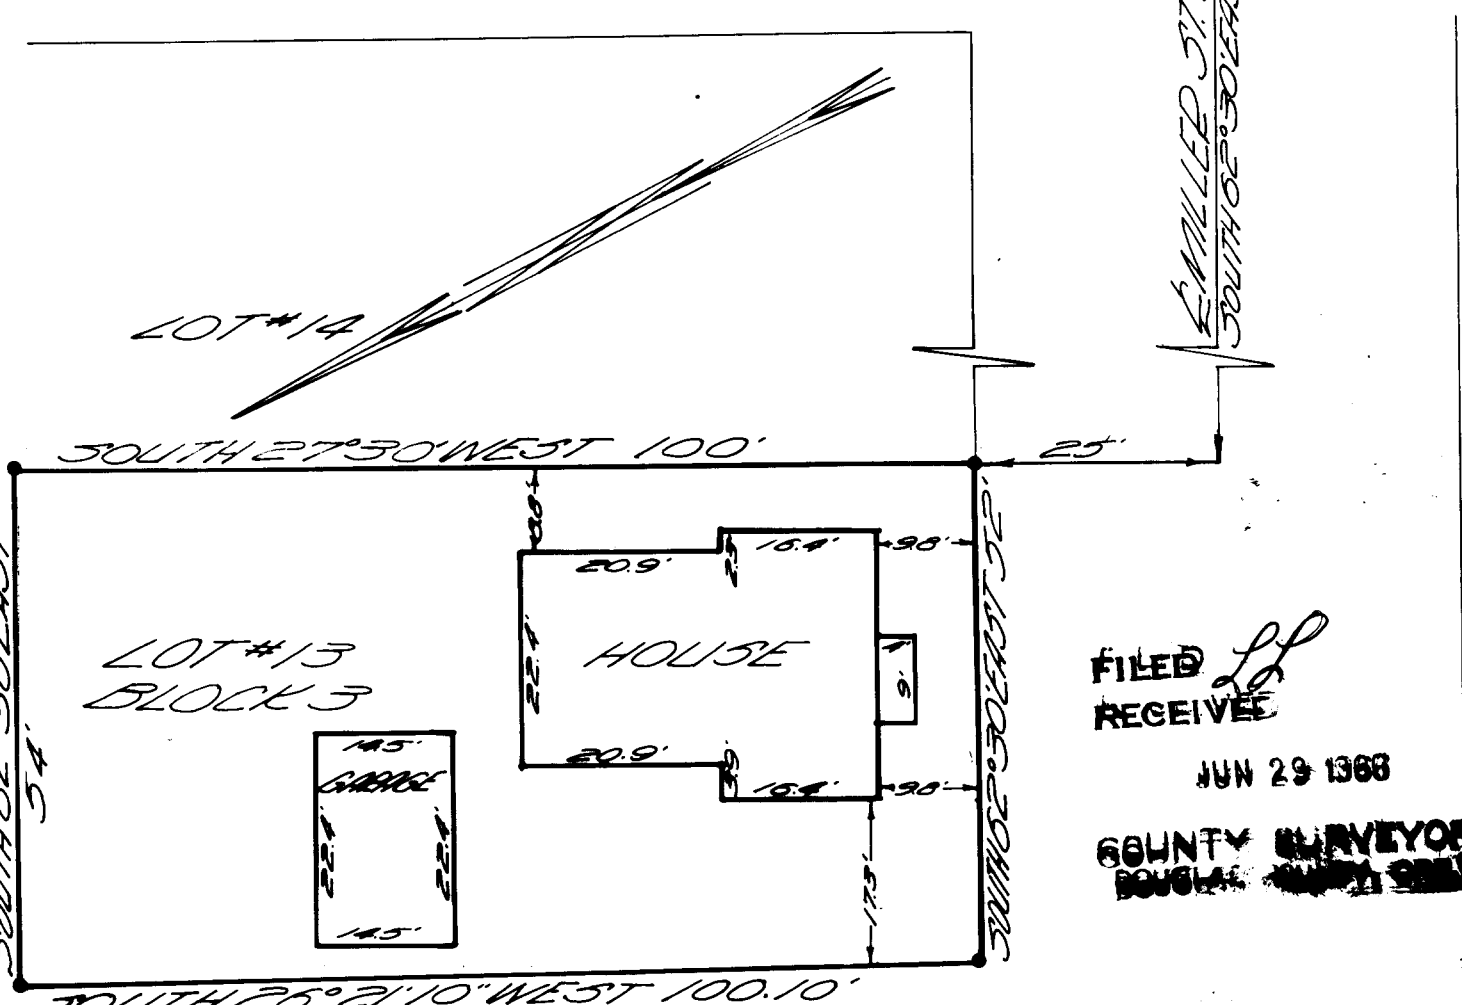

FILED *LL*  
 RECEIVED  
 JUN 29 1966  
 COUNTY SURVEYOR  
 BOULDER COUNTY, COLO.