


SURVEYED FOR PROPERTY CORNER RESTORATION  
 LOT NO. 14 SHERMAN SMITH SUBDIVISION  
 FOR DOUGLAS COUNTY TITLE COMPANY  
 BY BAUGHMAN SURVEYING SERVICE  
 SCALE 1 INCH = 20 FEET AUGUST 9, 1966

COUNTY SURVEYORS FILE DATA  
 DO NOT REMOVE FROM OFFICE

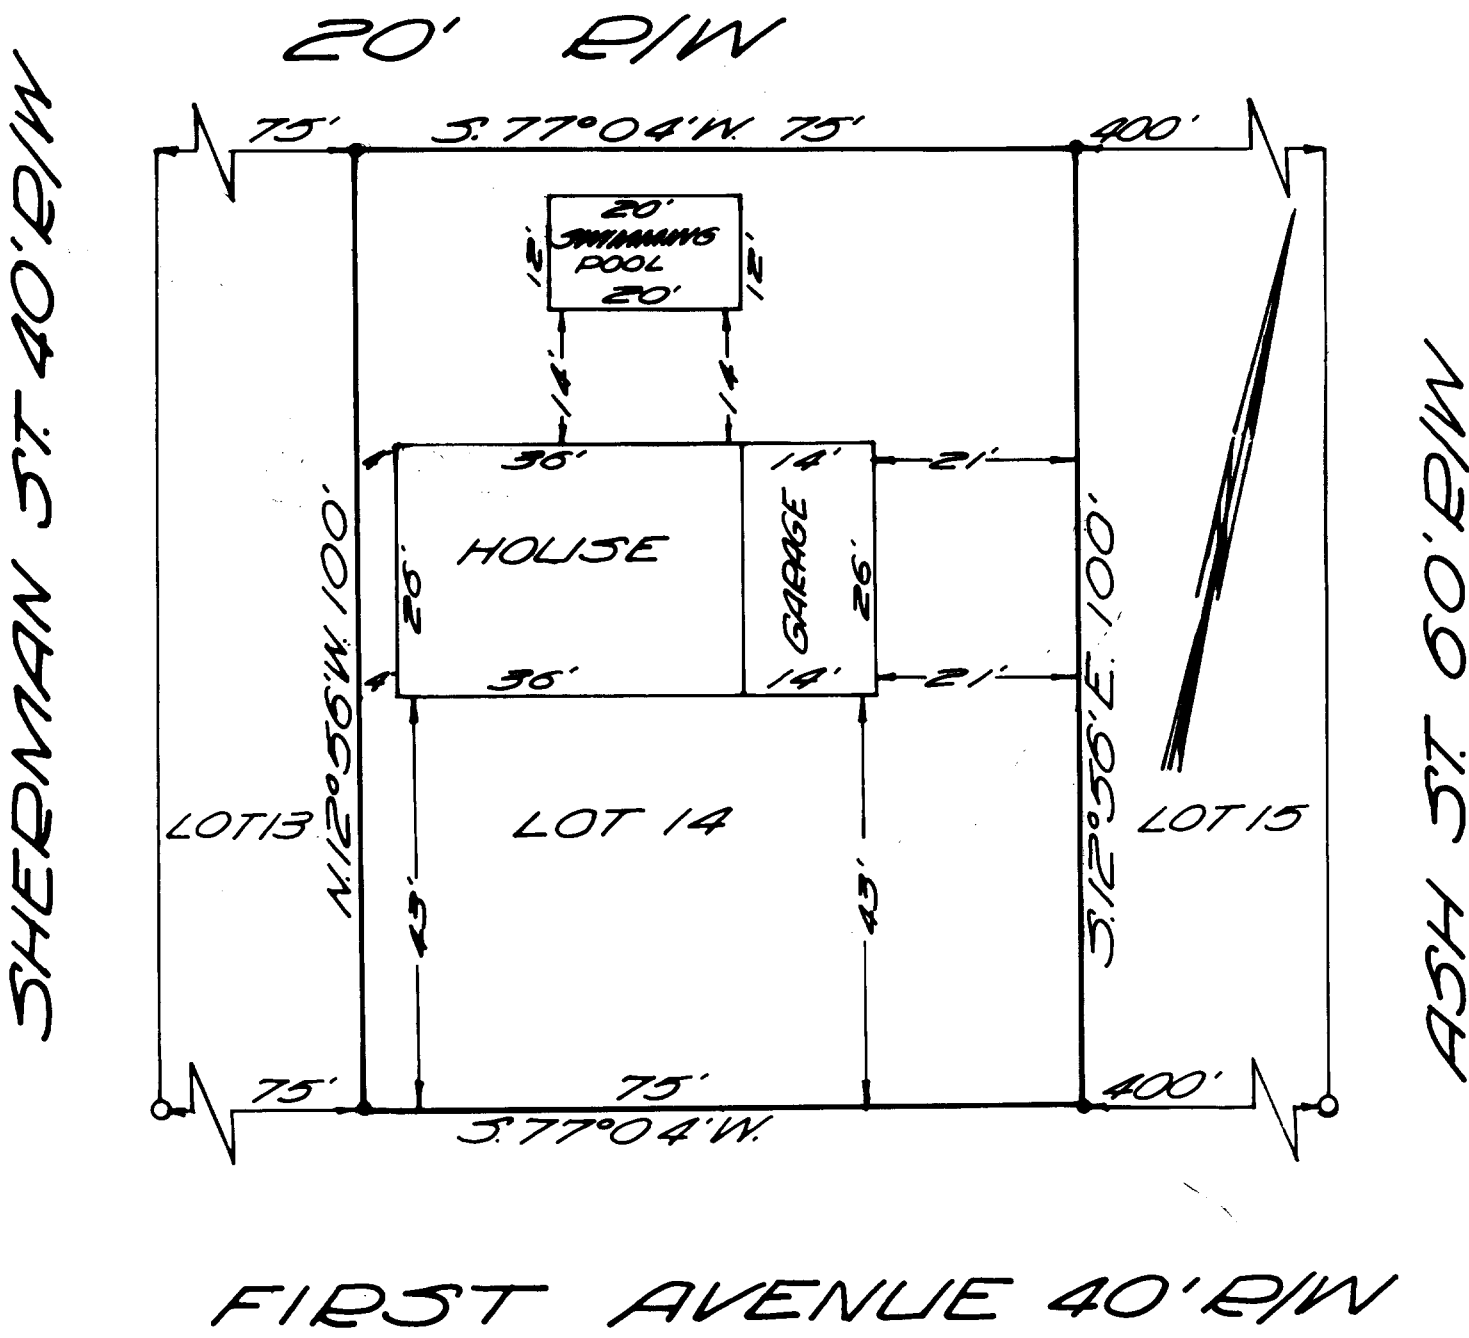

- FOUND 3/4" IRON PIPE
- SET 1/2" IRON ROD

FILED *LL*  
 RECEIVED

SEP 8 1966

COUNTY SURVEYOR  
 DOUGLAS COUNTY, ORE.

REGISTERED  
 OREGON  
 LAND SURVEYOR

*Glenn S. Baughman*

JULY 14, 1961  
 GLENN S. BAUGHMAN  
 536