


SKETCH of
RE-MARKED 1/4 SECTION CORNER
BET. SECS 2/3, T.33S., R.7W.W.M.

Scale: 1 in. = 100 ft.
Date: Sept 27, 1967.
Note: This work was
requested by and paid
for by Mr. R. Hissong of
Glendale, Oregon.

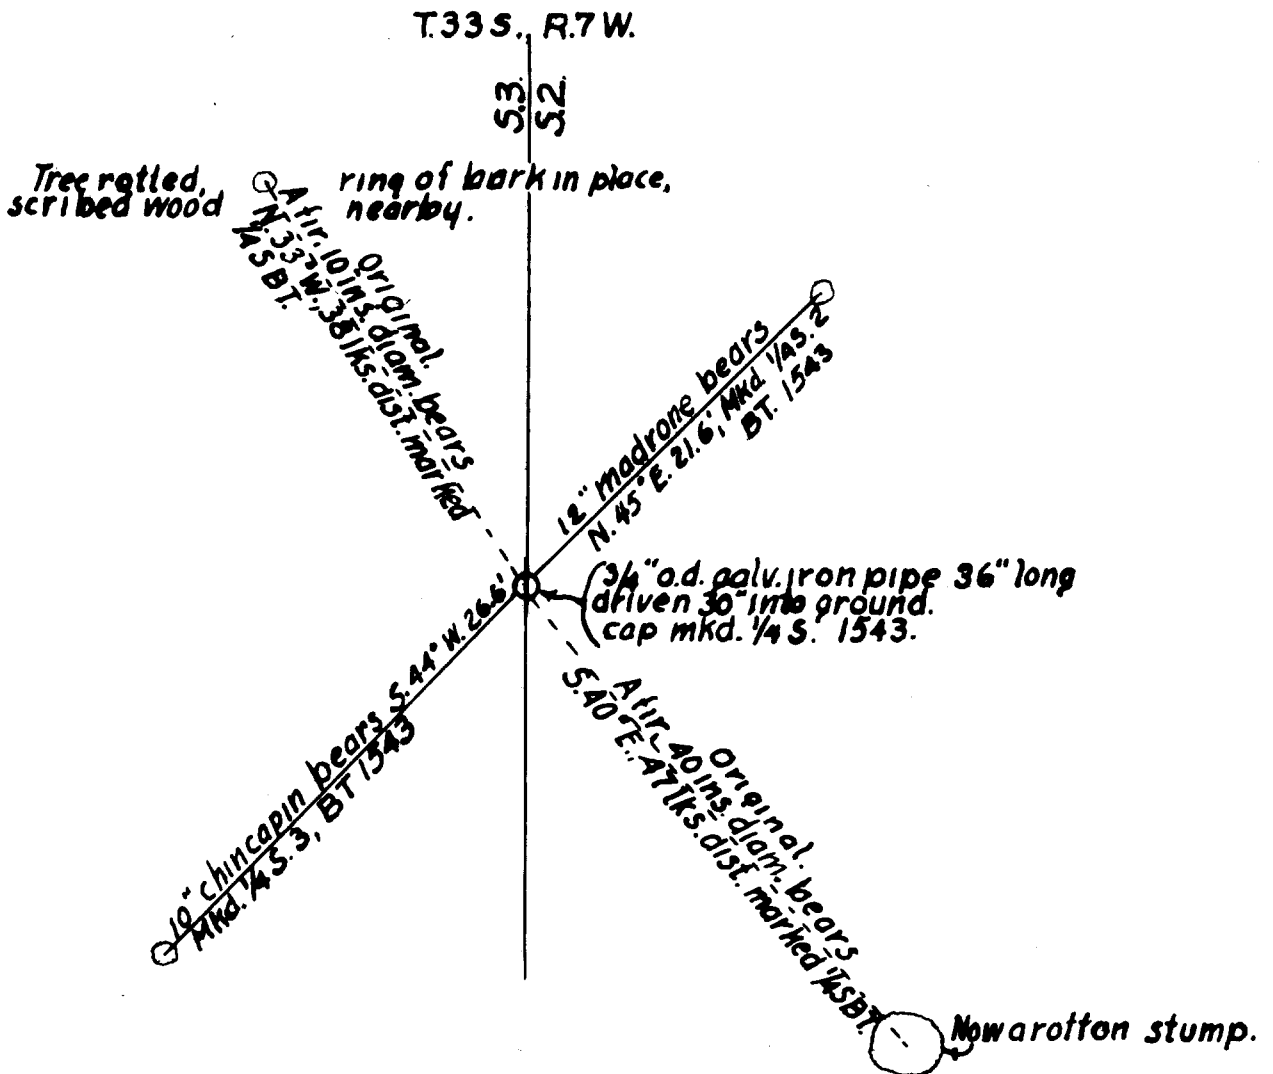

LL
OCT 3 1967

COUNTY SURVEYOR
CLATSOP COUNTY, ORE.