


**COUNTY SURVEYORS FILE DATA
DO NOT REMOVE FROM OFFICE**

SURVEY IN SECTION 16, T.27 S., R.6 W., W.M.

SURVEYED FOR JOHN L. BELL

SURVEYED BY R. H. GEE

JANUARY, 1967 - SCALE 1" = 200'

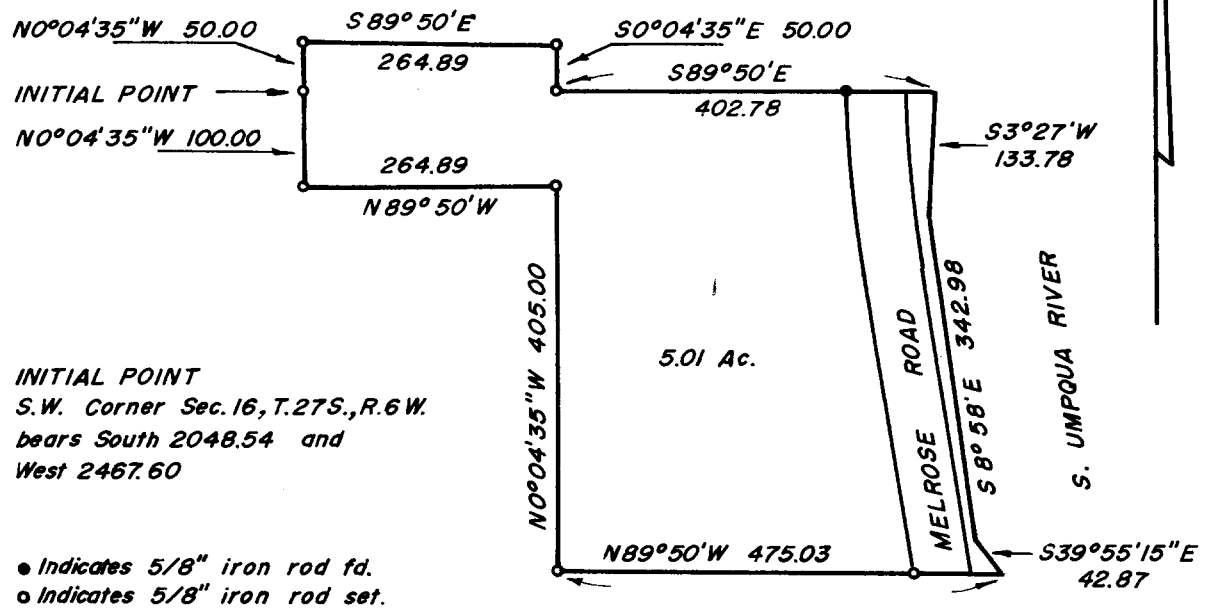

Bearings based on solar observation

FILED
RECEIVED

FEB 14 1967

COUNTY SURVEYOR
DOUGLAS COUNTY, ORE.