

SURVEYED FOR DEED DESCRIPTION
 LOCATED IN SEC. 15, T. 27 S., R. 6 W. W.M.
 SURVEYED FOR FRANK HOGG JR.
 BY BAUGHMAN SURVEYING SERVICE
 SCALE 1" = 40' MARCH 17, 1967
 • SET 5/8" IRON ROD

COUNTY SURVEYORS FILE DATA
 DO NOT REMOVE FROM OFFICE

REGISTERED
 OREGON
 LAND SURVEYOR

Glenn S. Baughman



JULY 14, 1961
 GLENN S. BAUGHMAN
 536

SEC. 10, 11, 14, 15

FILED
 RECEIVED

MAR 28 1967

COUNTY SURVEYOR
 DOUGLAS COUNTY, ORE.

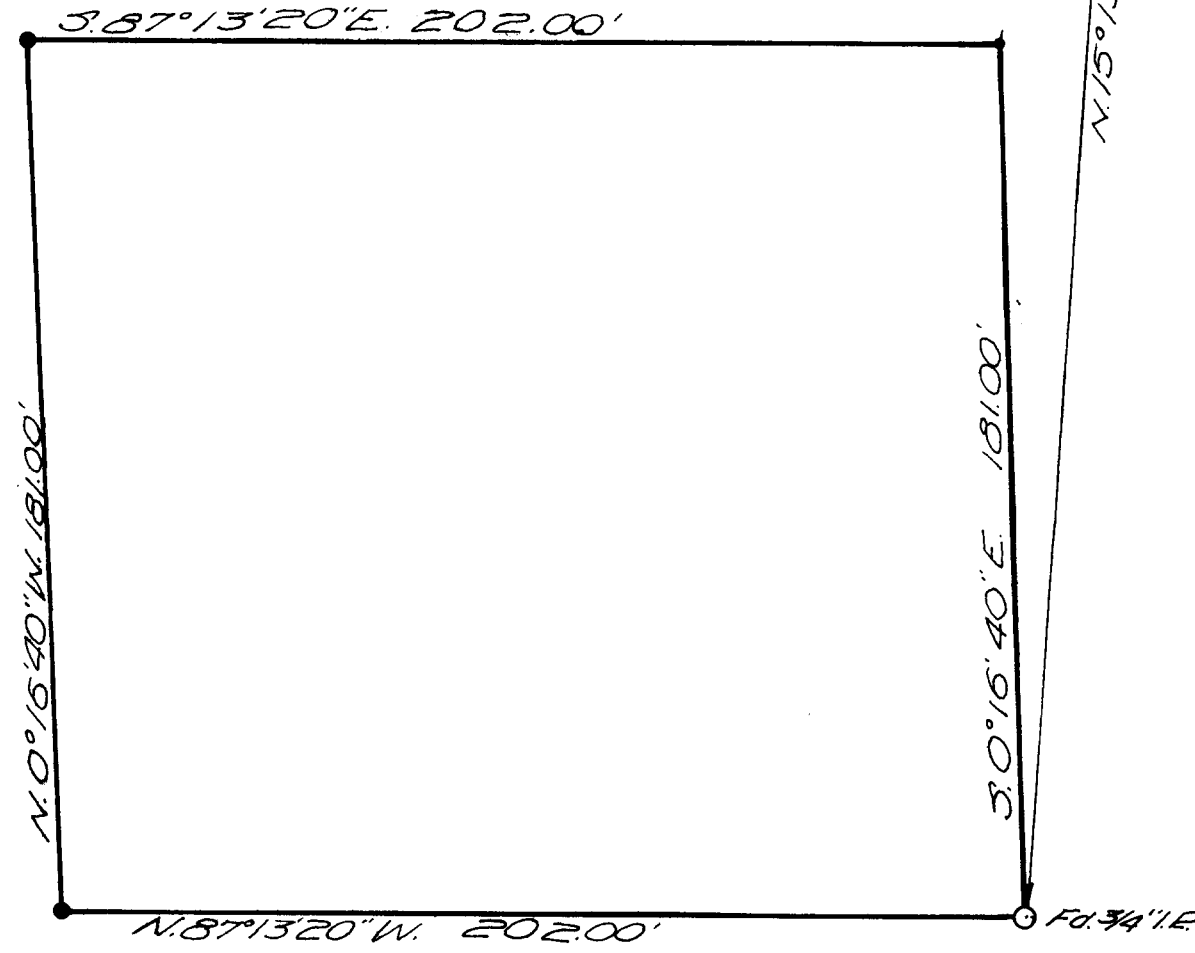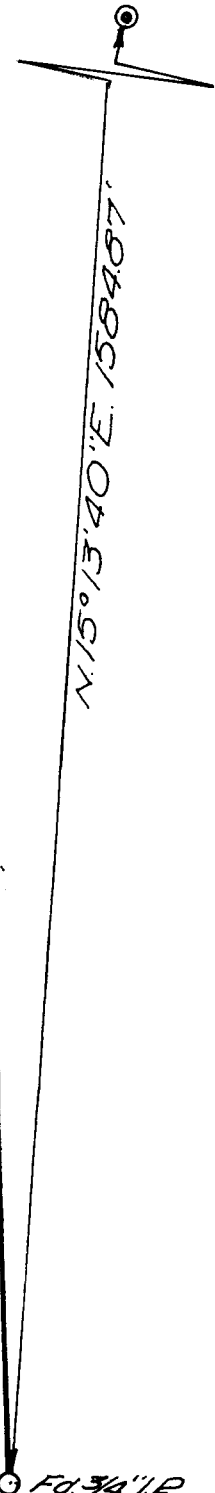

Stone Bearings Verm. Cr. 576. N. 0° 04' 40\"/>

FD. 3/4\"/>