

RESTORED CORNER FOR STATE OF OREGON--DEPARTMENT OF FORESTRY

Section corner common to Sections 3, 4, 9 and 10,
Township 20 South, Range 7 West, W. M., Lane and
Douglas Counties, Oregon.

ORIGINAL

Stone, now missing, from which a:

- 36" Fir bears S 12 E 54 lks.; now 30" burnt tree with scribes T 2 visible.
- 24" Fir bears S 87 W 54 lks.; now 30" burnt tree with scribes S 9 visible.
- 30" Fir bears N 19 W 8 lks.; now 36", burnt and down with face grown over.

RESTORED


Set 1½" x 36" galvanized iron pipe with 3" bronze cap marked "OREGON STATE BOARD OF FORESTRY T20S R7W S3 S4 S9 S10 1967 RS 563", 30 inches in ground, in edge of hole of uprooted NWBT, and from which a:

- 38" Burnt Fir bears S 66 W 50.6 ft.; scribed T 20 S R7W S10 BT RS 563.
- 44" Burnt Fir bears N 26 E 28.4 ft.; scribed T20S R7W S3 BT.
- 36" Burnt Fir bears N 60 W 38.5 ft.; scribed T20S R7W S4 BT.

Set 4" x 4" x 72" white painted Cedar post 1 ft. SE of corner pipe. Oregon State Forestry Department metal location poster on NE BT.

Dated April 10, 1967.

Restored by

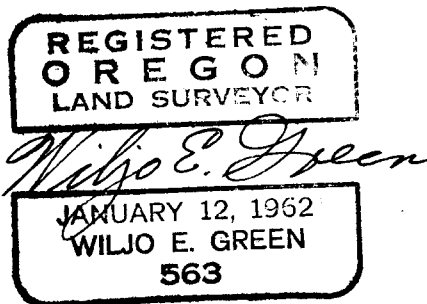

Present and witnessed by H. B. Baughn
C. B. Bedsaul
W. H. Scissons

FILED
RECEIVED

MAY 22 1967

COUNTY SURVEYOR
DOUGLAS COUNTY, ORE.

C.S. File

53/36

Map File

M 34 T 10

○ #62
○ 29/3 = 65