


CERTIFIED RECORD OF LAND CORNER MONUMENTATION

History of original corner establishment:

No corner had been previously set.

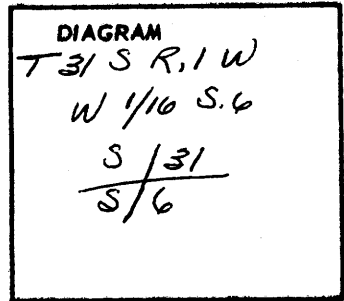


Description of corner evidence found:

None.

Description of monument and accessories I established to perpetuate the original location of this corner

I placed an iron pipe 30" long and 2" in diameter flaired at the bottom and capped with a bronze disk. The monument projects 6" inches above the ground. I filled in about the pipe monument with stone and packed earth.

I stamped the disk:

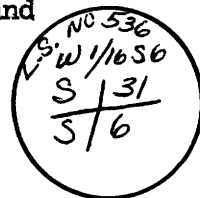

I established two new witness trees; a 6" Douglas fir which bears S 14° E. and a distance of 30.3 ft. ; blazed and scribed W 1/16 S. 6, B.T. also a 20" White fir which bears N 45° W. and a distance of 43.5 ft.; blazed and scribed W 1/16 S. 31, B.T.

Office of..... County of.....
State of....., I hereby certify that the within instrument was filed in this office
for record on the day of, 19....., at..... o'clockm., (signed)
..... by
(COUNTY OFFICIAL) (DEPUTY)