


CERTIFIED RECORD OF LAND CORNER MONUMENTATION

History of original corner establishment:

No previous corner had been set.

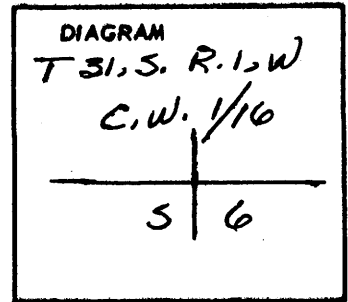


Description of corner evidence found:

None.

Description of monument and accessories I established to perpetuate the original location of this corner

I placed an iron pipe 30" long and 2" in diameter, flared at the bottom and capped with a bronze disk. Monument projects 6 inches above ground. I filled in around the pipe with stone and packed earth.

I stamped the disk:

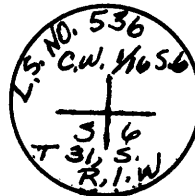

I established two new witness trees, a 5" cedar which bears S. 70° E. and a distance of 22.6 ft.; blazed and scribed C.W. 1/16 S.6., B.T., also a 4" Cedar which bears N.64° E. and a distance of 15.4 ft., blazed and scribed C.W. 1/16 S.6. B.T.

Office of County of

State of, I hereby certify that the within instrument was filed in this office for record on the day of, 19, at o'clockm., (signed)

..... by

(COUNTY OFFICIAL) (DEPUTY)