


CERTIFIED RECORD OF LAND CORNER MONUMENTATION

History of original corner establishment:

No corner had previously been set.

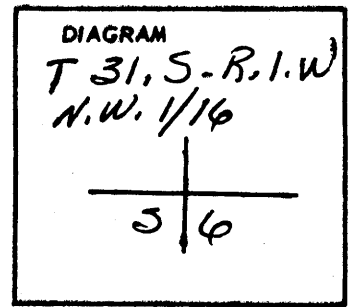

Description of corner evidence found:

None.

Description of monument and accessories I established to perpetuate the original location of this corner

I placed an iron pipe 30" long and 2" in diameter, flared at the bottom and capped with a bronze disk. Monument projects 6 inches above ground. I filled in around the pipe monument with stone and packed earth.

I stamped the disk:



I also established two new witness trees a 16" Cedar which bears S 2 1/2° W. and a distance of 21.9 ft. blazed and scribed N.W. 1/16 S.6., B.T. also a 10" Douglas Fir which bears N. 1° W. and a distance of 61.2 ft., blazed and scribed N.W. 1/16 S.6, B.T.

Office of..... County of.....
 State of....., I hereby certify that the within instrument was filed in this office
 for record on the day of; 19....., at..... o'clockm., (signed)
 by
 (COUNTY OFFICIAL) (DEPUTY)