


CERTIFIED RECORD OF LAND CORNER MONUMENTATION

History of original corner establishment:

No previous corner had been set.

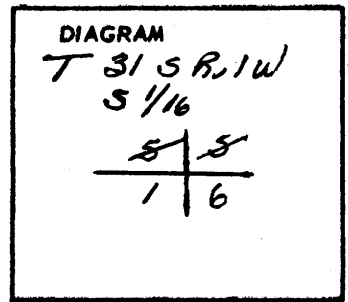


Description of corner evidence found:

none.

Description of monument and accessories I established to perpetuate the original location of this corner

I placed an iron pipe 30" long and 2" in diameter, flared at the bottom and capped with a bronze disk. Monument projects 6 inches above ground. I filled in about the pipe monument with stone and packed earth.

I stamped the disk:

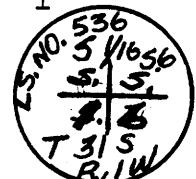

I established two new witness trees a 6" oak bears N. 21 $\frac{1}{2}$ ^o W. 32.3 ft. dist. blazed and scribed S 1/16 S.l., B.T. also a 12" oak which bears S. 12^o W. 35.1 ft. dist. blazed and scribed S 1/16 S. 6, B.T.

sl

Office of County of

State of, I hereby certify that the within instrument was filed in this office for record on the day of, 19....., at o'clockm., (signed)

..... by

(COUNTY OFFICIAL) (DEPUTY)