


CERTIFIED RECORD OF LAND CORNER MONUMENTATION

History of original corner establishment:

No corner had been previously set.

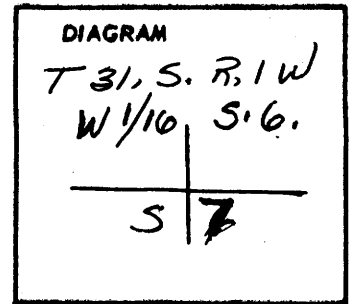


Description of corner evidence found:

None.

Description of monument and accessories I established to perpetuate the original location of this corner

I placed an iron pipe 30" long and 2" in diameter, flared at the bottom and capped with a bronze disk. Monument projects 6 inches above ground. I filled in around the pipe monument with stone and packed earth.

I stamped the disk:

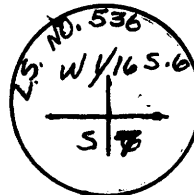

I established two new witness trees a 14" Douglas Fir which bears N. 63° E. and a distance of 52.5 ft.; blazed and scribed W 1/16 S. 6., B.T. also a 24" Oak which bears S 23° E. and a distance of 71.0 ft.; blazed and scribed W 1/16 S. 7., B.T.

Office of ..... County of .....

State of ....., I hereby certify that the within instrument was filed in this office for record on the ..... day of ....., 19 ....., at ..... o'clock .....m., (signed)

..... by ..... (COUNTY OFFICIAL) (DEPUTY)