


CERTIFIED RECORD OF LAND CORNER MONUMENTATION

History of original corner establishment:

Original survey by Dennis Hathorn, Deputy Surveyor.
 Under his contract No. 73, dated June 8th, 1857.
 Set post, cor. Sec's. 6,7,1 and 12, from which an Oak, 10"
 in diam. which bears N. 14° W., 100 lks. dist., an Oak, 12"
 in diam. which bears N. 28° E., 36 lks. in dist., an Oak, 9"
 in diam. which bears S 18° W., 79 lks. in dist., a pine
 24" in diam. which bears S. 68° E., 49 lks. in dist.

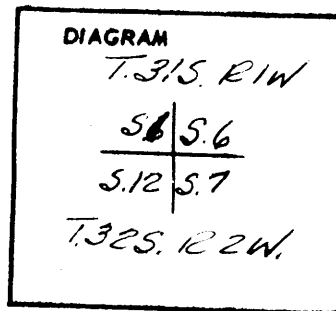


Description of corner evidence found:

I found one tree, a pine 48" in diameter which had been burned and cut out, but found no legible scribe. We also found a 1/2" pipe which has evidently been used as the section corner. This pipe is situated 13' North of a East-West fence which we found by proportion to be nearer the correct distance.

Description of monument and accessories I established to perpetuate the original location of this corner

I placed an iron pipe 30" ft. long and 2" in. in diam., flared at the bottom and capped with a bronze disk. Monument projects 6 inches above ground. I filled in around the pipe monument with stone and packed earth. 3' north of an East-West fence & in line with North fence.

I stamped the disk:

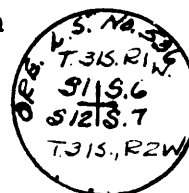

I also established four witness trees. A sugar pine 16" in diam. which bears N. 54° W. and 1.7' ft. in dist. Blazed and scribed T 31 S. R 1 W. S 1., B.T. also a Douglas Fir 8" in diam. which bears N. 14 1/2° E. and 51.7 in dist., blazed and scribed T 31 S., R 2 W. S. 7., B.T. also a 10" Douglas fir which bears S 86° E and 35.6 in dist., blazed and scribed T 31 S, R 2 W. S 12., B.T. also a 10" cedar which bears S 34 1/2° W. and 15.9 in dist., blazed and scribed T 31 S, R 1 W. S 6., B.T.

Office of County of
 State of, I hereby certify that the within instrument was filed in this office
 for record on the day of, 19....., at o'clock m., (signed)
 by
 (COUNTY OFFICIAL) (DEPUTY)