


CERTIFIED RECORD OF LAND CORNER MONUMENTATION

History of original corner establishment:

Original survey by Dennis Hathorn Deputy Surveyor,
Under contract No. 73, dated June 8, 1857
Set 1/4 sec. post from which, a fir, 15" bears N. 45° E.,
80 lks. dist. also an oak, 12" diameter, which bears
S 70° W, 183 lks. dist.

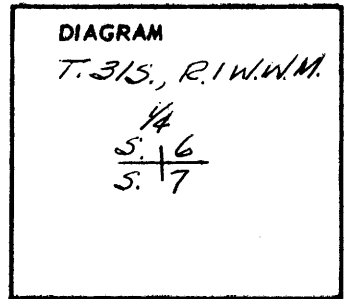


Description of corner evidence found:

None

Description of monument and accessories I established to perpetuate the original location of this corner

I placed an iron pipe 30" long and 2" in diameter, flared at the bottom and capped with a bronze disk. Monument projects 6 inches above ground
I filled in about the pipe monument with stone and packed earth.

I stamped the disk. _____

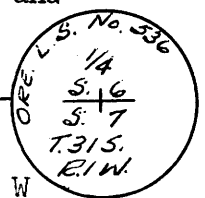

I established two new witness trees; a 14" douglas fir which bears N. 24° W
6.6 ft. dist. blazed and scribed 1/4, S. 6., B.T. Also, a 20" Broad leaf
maple which bears S 15° W. 217.5 ft. dist. blazed and scribed 1/4 S. 7., B.T.

Office of County of
State of , I hereby certify that the within instrument was filed in this office
for record on the day of , 19..... , at o'clock m., (signed)
..... by
(COUNTY OFFICIAL) (DEPUTY)