


CERTIFIED RECORD OF LAND CORNER MONUMENTATION

History of original corner establishment:

No corner had been previously set.

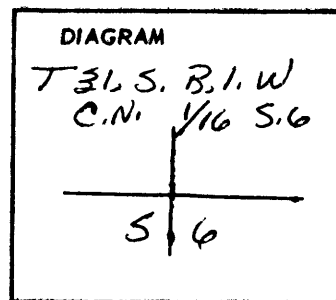

Description of corner evidence found:

None.

Description of monument and accessories I established to perpetuate the original location of this corner

I placed an iron pipe 30" long and 2" in diameter, flared at the bottom and capped with a bronze disk. Monument projects 6 inches above ground. I filled in around the pipe with stone and packed earth.

I stamped the disk:



I established two new witness trees a 4" Willow which bears S. 15° E. and a distance of 50.7 ft. ; blazed and scribed C.N. 1/16 S. 6., B.T., also a 3" Willow which bears S. 34 1/2° W. and a distance of 68.7 ft.; blazed and scribed C.N. 1/16 S. 6., B.T.

Office of ..... County of .....  
 State of ..... , I hereby certify that the within instrument was filed in this office  
 for record on the ..... day of ..... , 19..... , at ..... o'clock .....m., (signed)  
 ..... by .....  
 (COUNTY OFFICIAL) (DEPUTY)