


CERTIFIED RECORD OF LAND CORNER MONUMENTATION

History of original corner establishment:

No previous corner had been set.

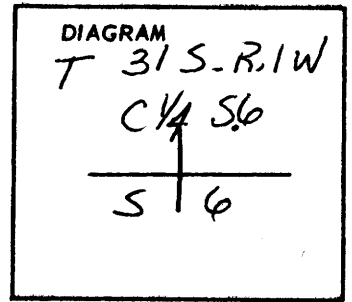


Description of corner evidence found:

None.

Description of monument and accessories I established to perpetuate the original location of this corner

I placed an iron pipe 30" long and 2" in diameter, flared at the bottom and capped with a bronze disk. Monument projects 6 inches above ground. I filled in about the pipe monument with stone and packed earth.

I stamped the disk:

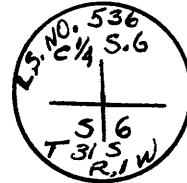

I established two new witness trees; a 8" white fir which bears N. 83 1/2° E. and a distance of 22.6'. Blazed and scribed C 1/4 S. 6., B.T. Also, a 10" white fir which bears S. 83° W. and a distance of 51.2'ft. Blazed and scribed C 1/4 S. 6., B.T.

Office of County of

State of, I hereby certify that the within instrument was filed in this office for record on the day of, 19....., at..... o'clockm., (signed)

..... by

(COUNTY OFFICIAL) (DEPUTY)