

COUNTY SURVEYORS FILE DATA
DO NOT REMOVE FROM OFFICE


SURVEY FOR
HOWARD AUSTIN
IN
LOT 4, SEC. 20, T. 26 S., R. 6 W., W.M.

SURVEYED: JUNE 1967

SCALE: 1" = 200'


BY

BRYANT ENGINEERING & SURVEYING

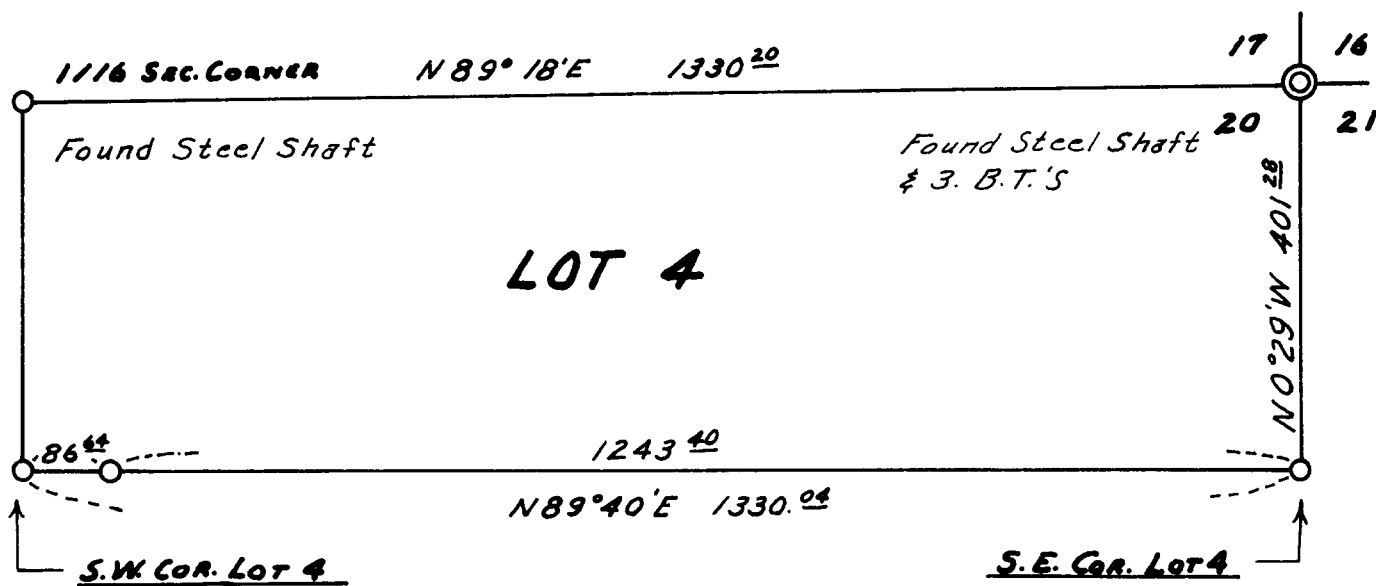

Set 3/8" Re-bar
Mark a 7 3/4" Diameter W. Oak
With letters "BT"
W. Oak Bears N 20° W 33 3/4 ft.

S.E. COR. LOT 4
Set 3/8" Re-bar

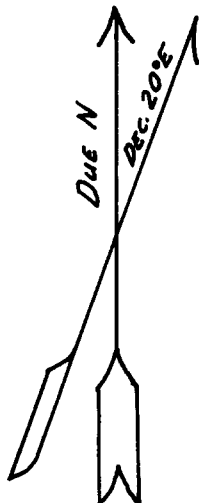

NOTE: All bearings
based on
Solar Observations

JUN 11 1967

DENNIS O. BRYANT
REGISTERED PROFESSIONAL ENGINEER