

SURVEY FOR DEED DESCRIPTION

LOCATED IN SEC. 5, T.32S, R.4 W.W.M.


FOR TROY & EDNA CARDIN JAN. 2, 1968

BY BAUGHMAN & ACKARST INC.

SCALE 1"=100'

• SET 58' IRON ROD
0 AS SHOWN

COUNTY SURVEYORS FILE DATA
DO NOT REMOVE FROM OFFICE

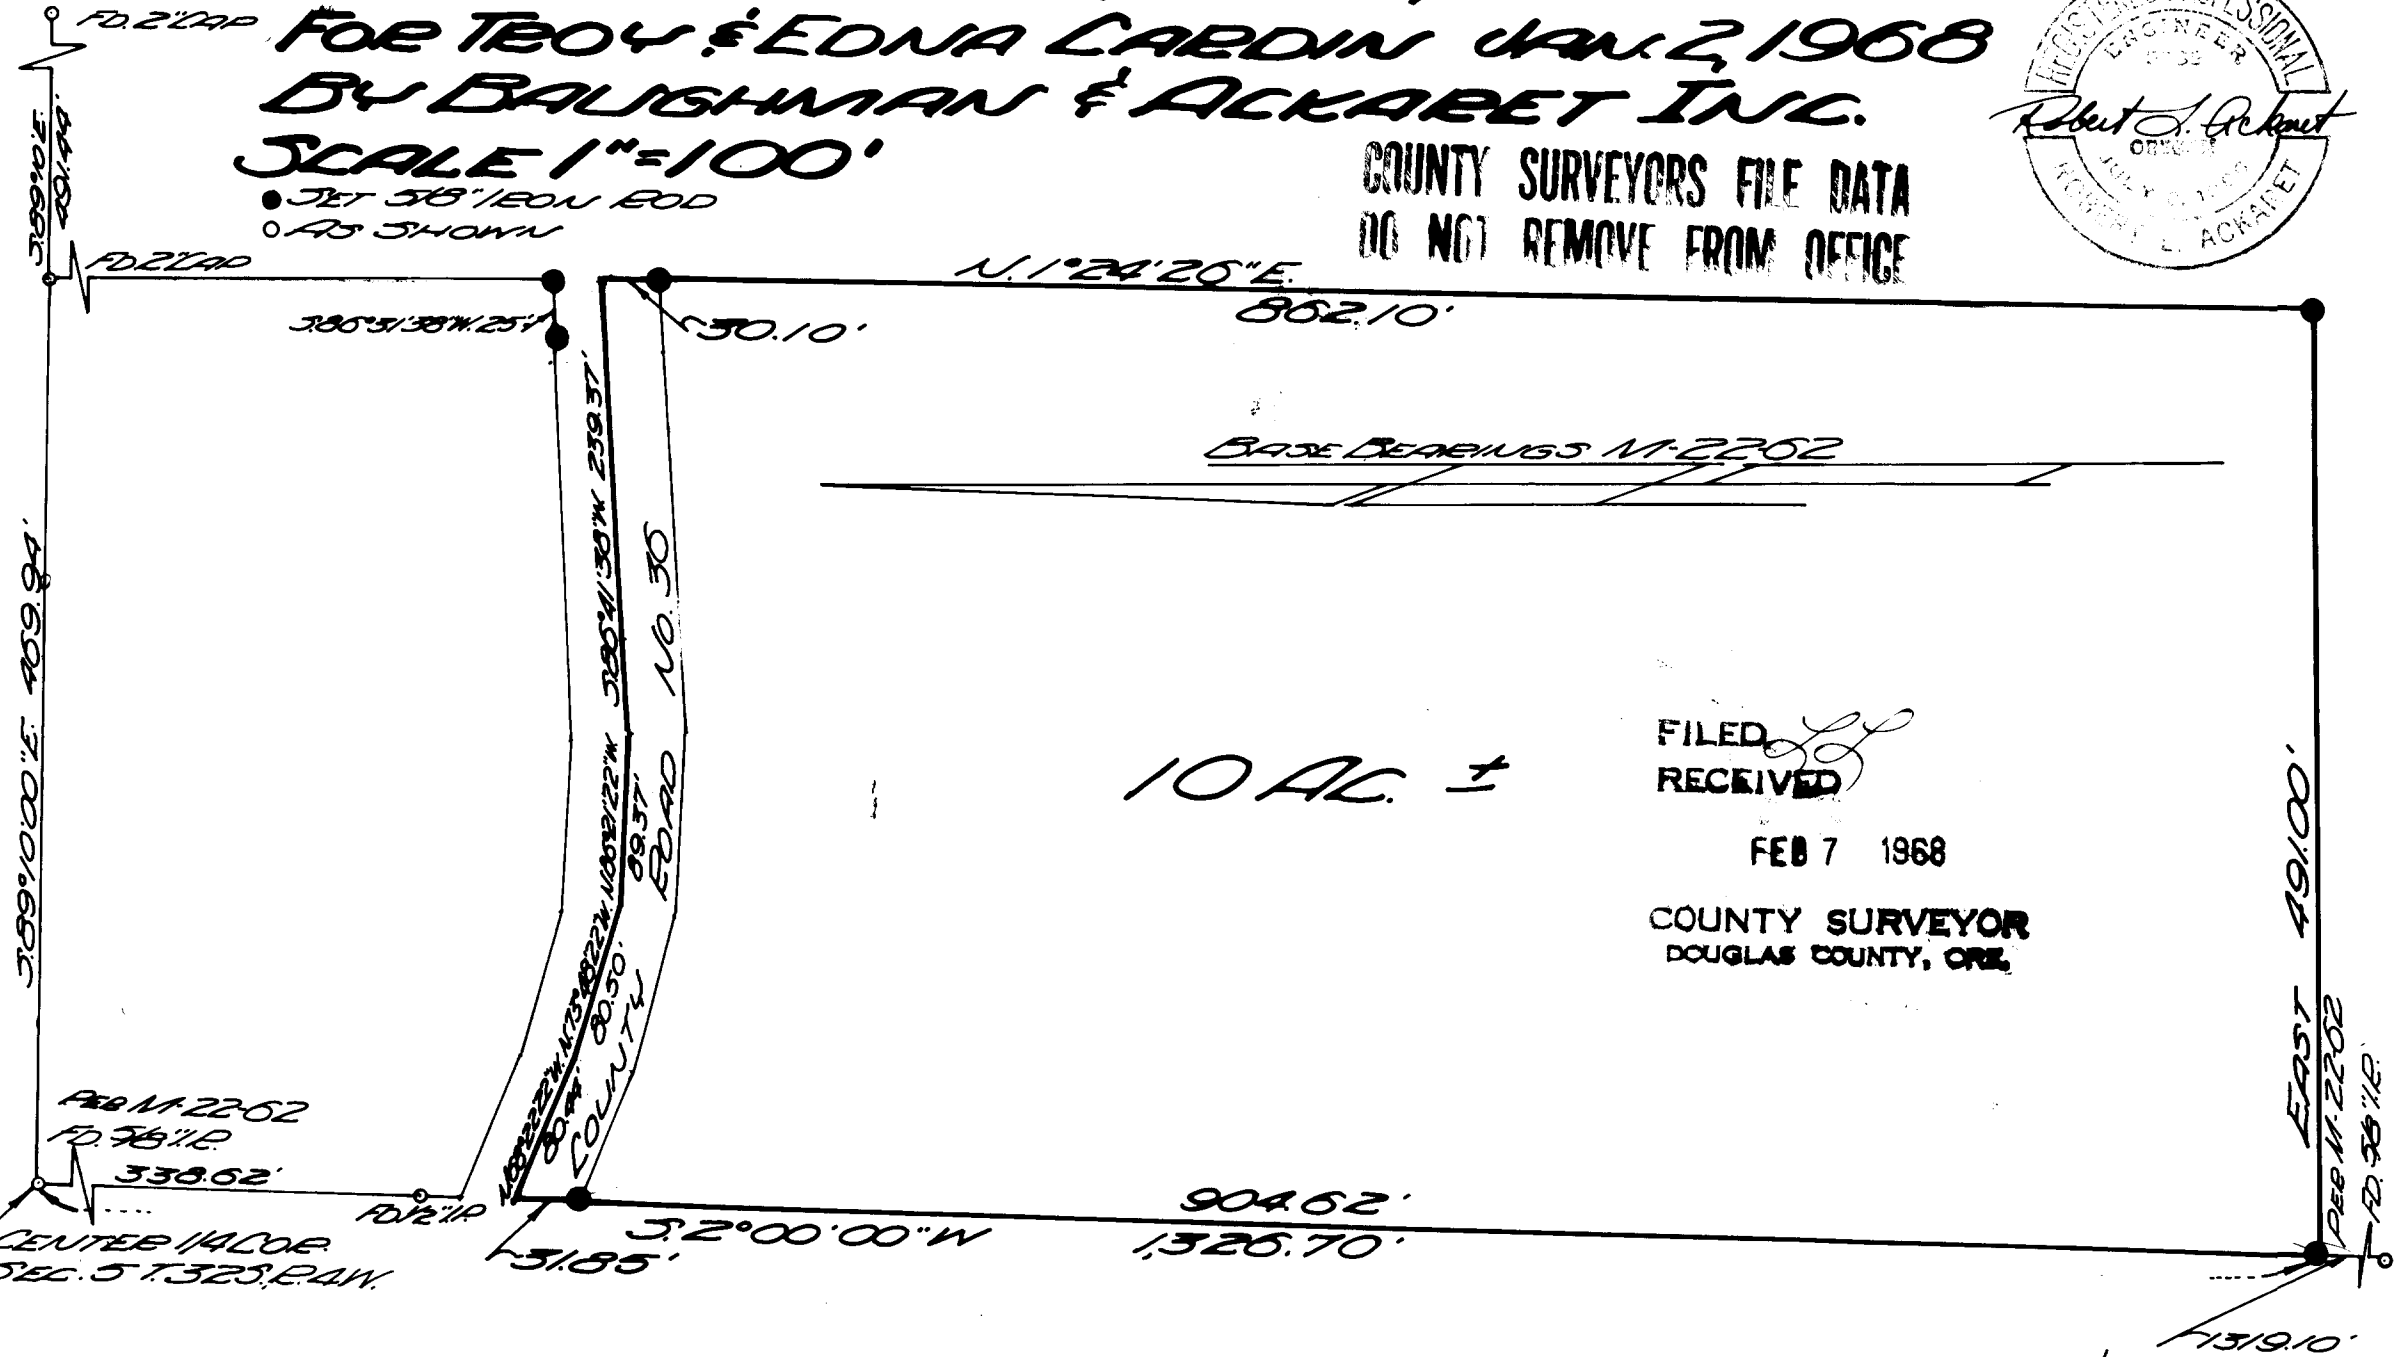

10 AC. ±

FILED
RECEIVED

FEB 7 1968

COUNTY SURVEYOR
DOUGLAS COUNTY, ORE.