


**SURVEYED FOR DEED DESCRIPTION
 LOCATED IN SECTION 6, TWP 27S, R6W, W.M.
 FOR DOUGLAS COUNTY FIRE PROTECTION DISTRICT 2
 BY BAUGHMAN & ACKARET INC. JULY 10, 1967
 SCALE 1"=50'**

**COUNTY SURVEYORS FILE DATA
 DO NOT REMOVE FROM OFFICE**



C.S. File No. 5588-1-1

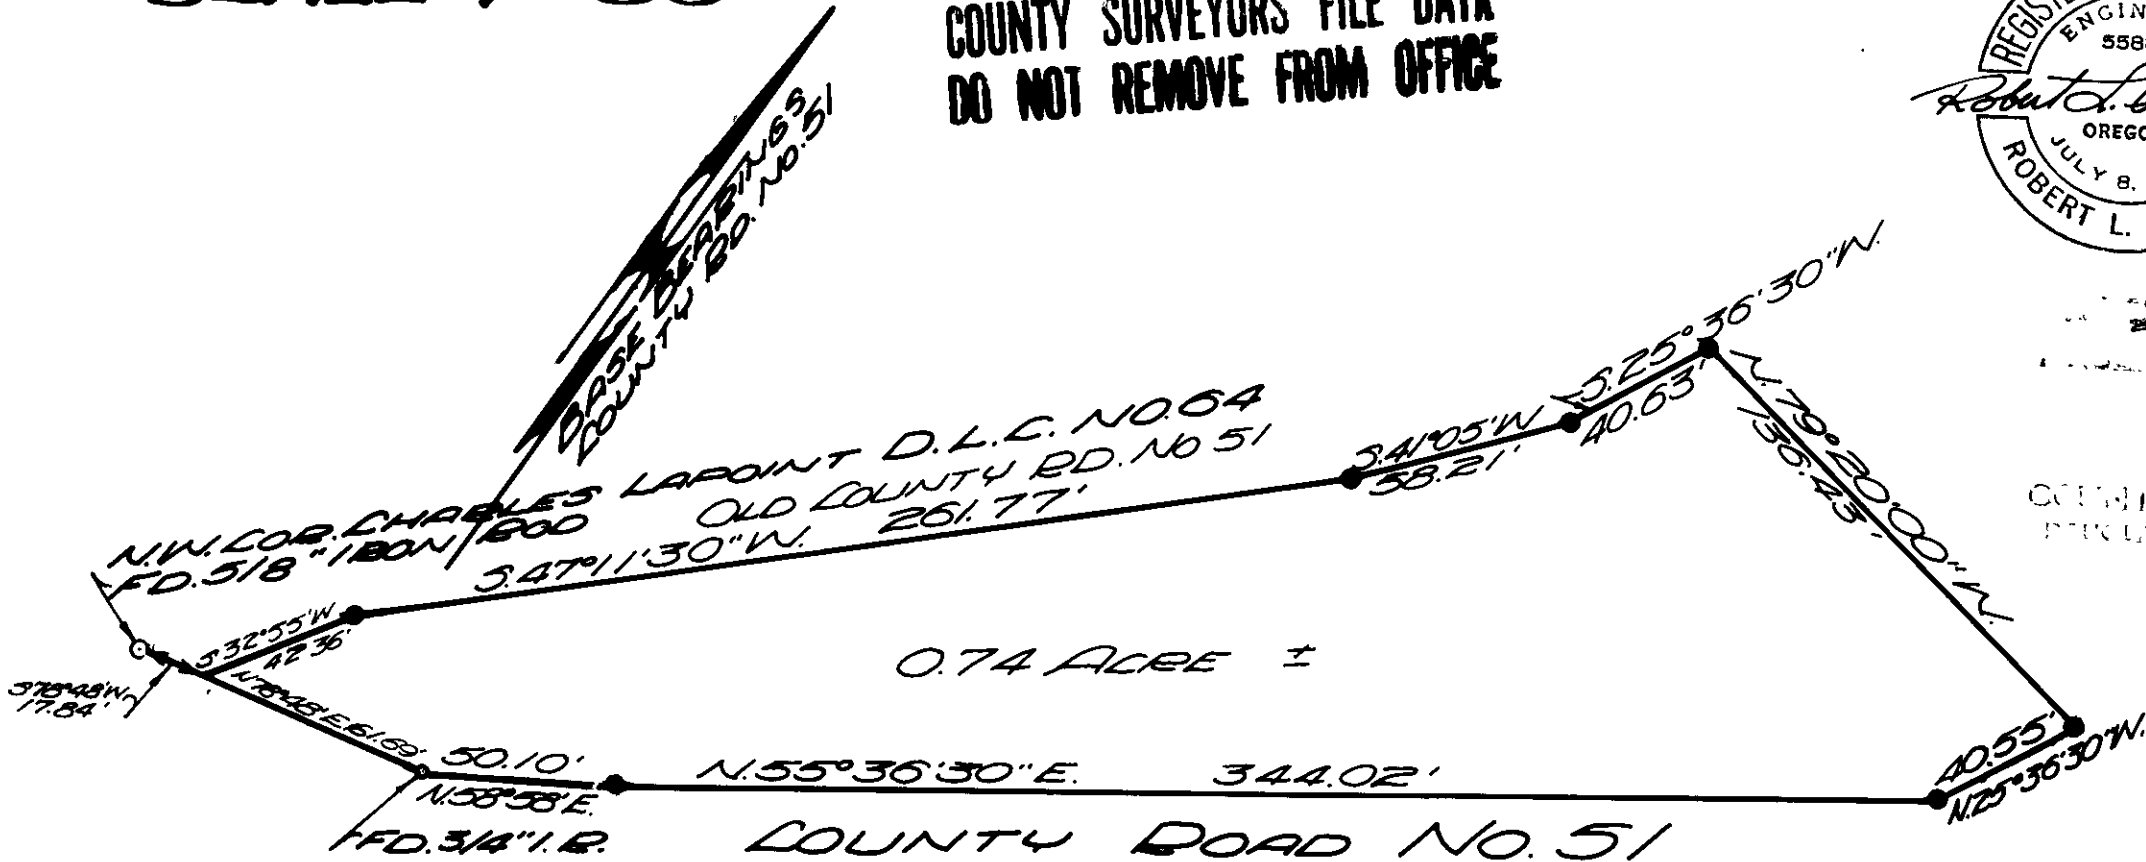

7 1963
 COUNTY SURVEYORS
 DOUGLAS COUNTY, OREGON

- SET 3/8" IRON ROD
- AS NOTED