

DESTORATION OF LOT CORNERS: LOT 6, BLOCK 2, SUN DALE VILLAGE FOR WILLIAM H. MAUDE BY BAUGHMAN & ACKERET INC.

SCALE 1"=60'

DEC 11, 1967


• SET 5/8" IRON ROD

COUNTY SURVEYORS FILE DATA
DO NOT REMOVE FROM OFFICE

REGISTERED
OREGON
LAND SURVEYOR

Alvin S. Baughman

CLINCH R. ...
...
...

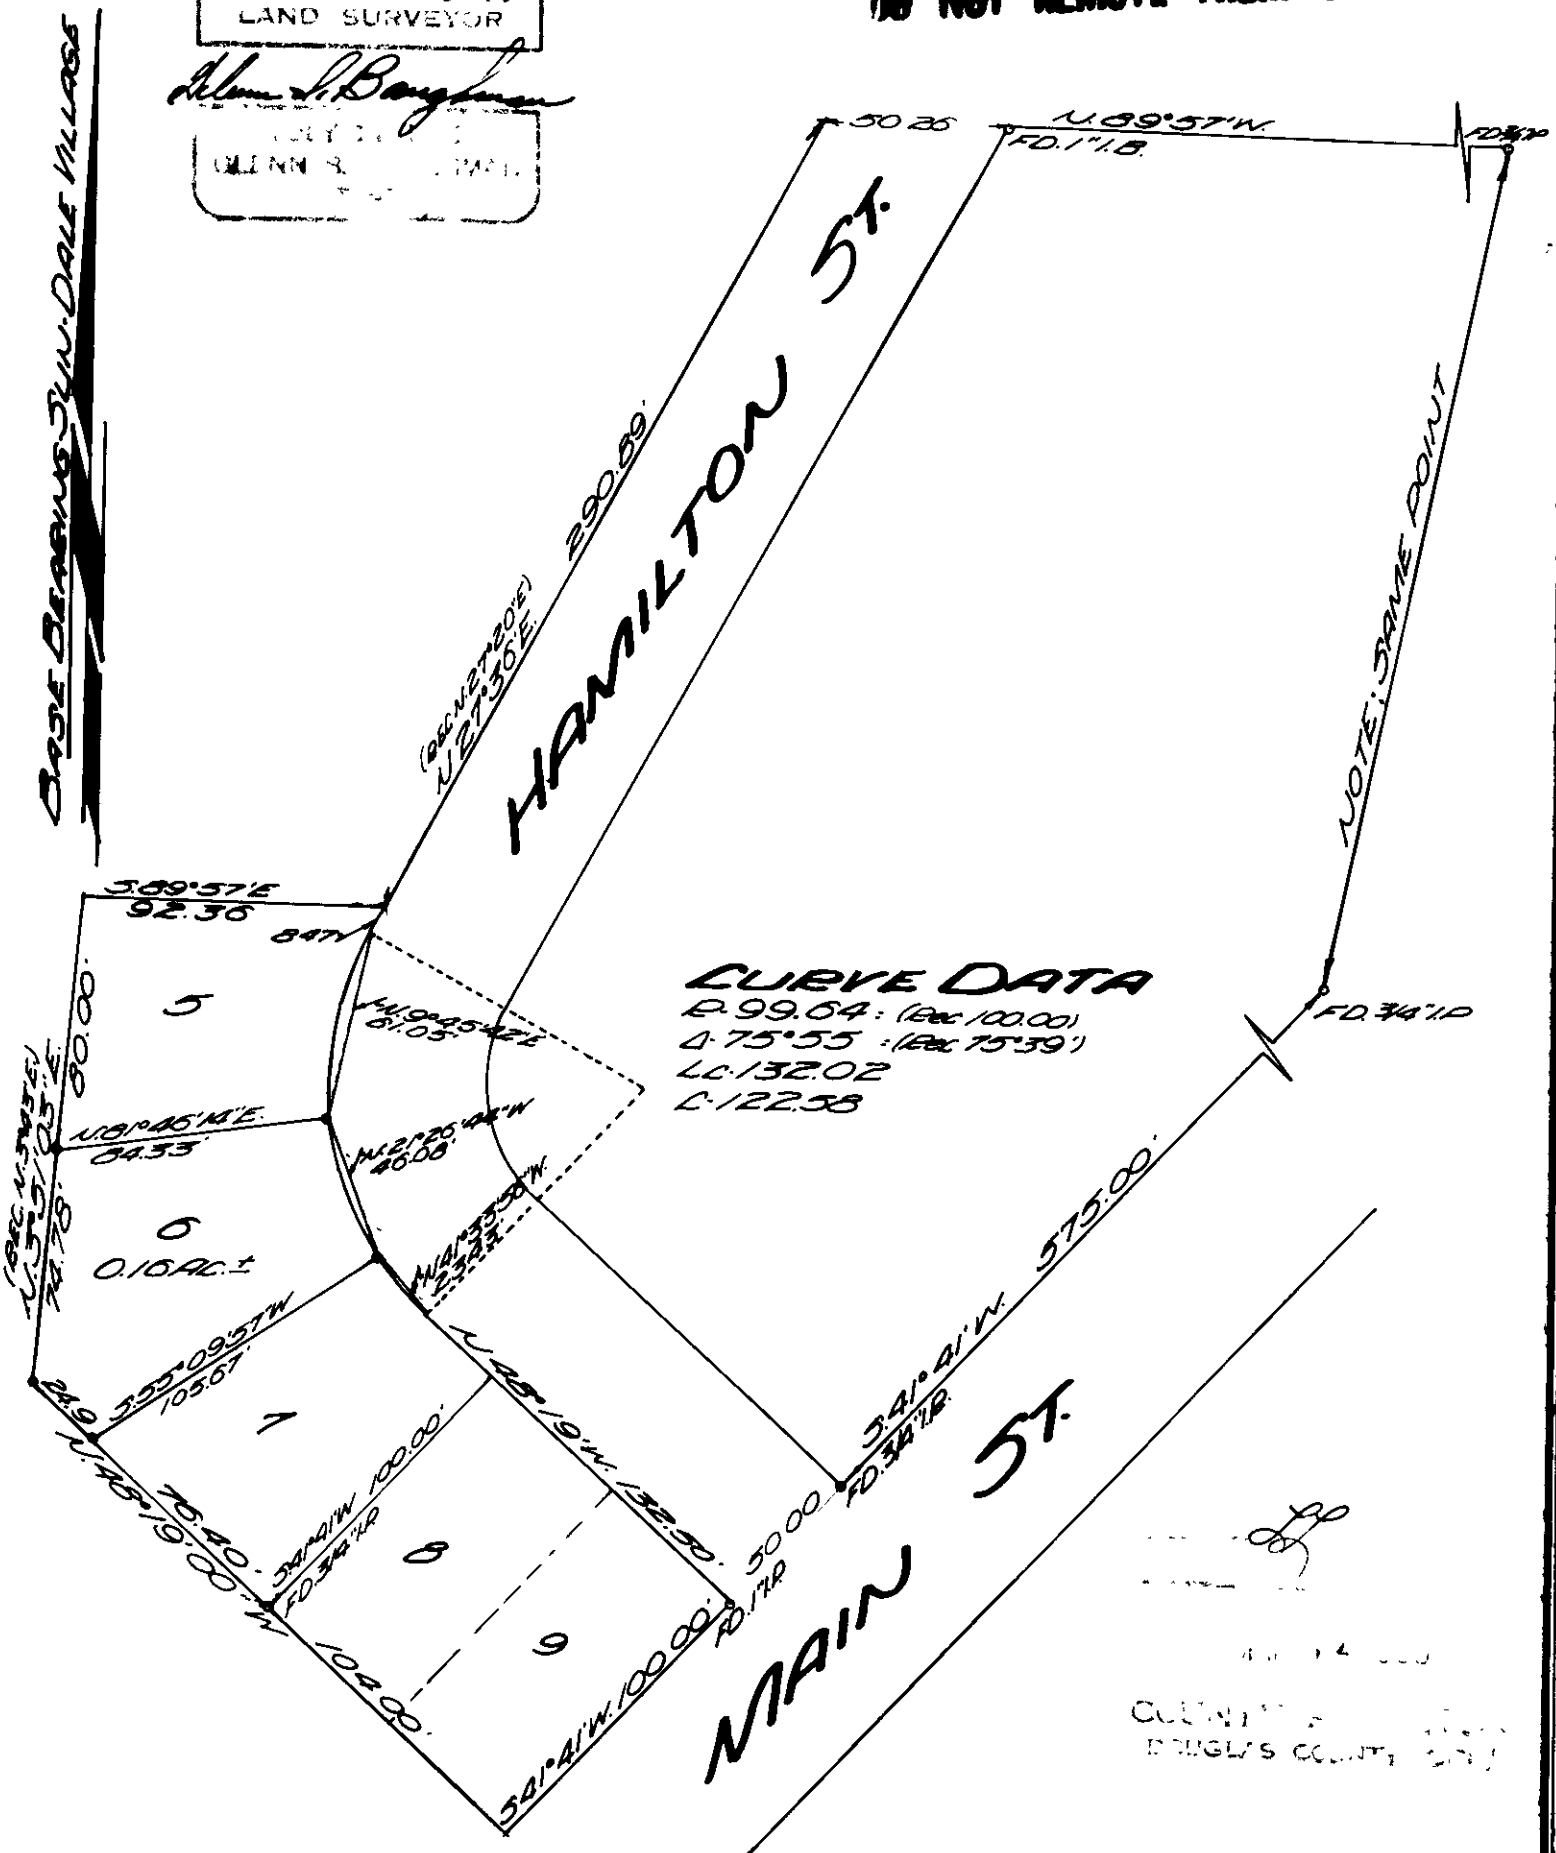

CURVE DATA
 R: 99.64: (ARC 100.00)
 Δ: 75°55' (ARC 75°39')
 LC: 132.02
 C: 122.58

[Signature]
 COUNTY SURVEYORS
 DEPT. OF LAND & FORESTRY
 BRIGGS COUNTY, OREGON