

Shaner's Engineering & Surveying

PLANNING • SURVEYING • ENGINEERING

P. O. BOX 627

ROSEBURG, OREGON 97470

To: Douglas County Surveyor, Roseburg, Oregon

November, 1967

LEGAL CORNER RE-ESTABLISHED FOR U. S. FOREST SERVICE

At the quarter section corner common to Sections 15 & 22, Township 26 South, Range 1 West, W. M., Douglas County, Oregon (Umpqua National Forest), I found a conglomerate stone, 12" x 8" x 6" marked 1/4 on the north face, and from which stone a:

original, 14" diameter

a Madrone bearing tree, bearing N42°W a distance of 8.6 feet, is now missing, but at which point there is a hole in the ground with 6" diameter madrone trees growing alongside.

a Madrone bearing tree, original, 14" diameter, bearing S9°W, 14.5 feet, now missing.

a 4 inch diameter Hemlock, bearing S5°E, 3.4 feet, I scribed "1/4 S, S22, BT".

a 8 inch diameter Hemlock, bearing N5°E, 77.0 feet, I scribed "1/4S, S15, BT".

#18

LEGAL CORNER FOUND FOR U. S. FOREST SERVICE

At the Section Corner common to Sections 14, 15, 22, 23, Township 26 South, Range 1 West, W.M., Douglas County, Oregon, (Umpqua National Forest), I found a 6 inch diameter stone with "X" chiseled on top (record stone was 15" x 10" x 8"), from which corner stone a:



60" Cedar, original bearing tree with scar grown over face, bears N30°E, 10.6 feet.

12" Cedar Snag, original bearing tree with scribes "- 26S, RLW, S23 " visible, bears S22°E, 54.7 feet.

36" Douglas Fir, original bearing tree, now blown down, bears S26°W, 23.8 feet.

6" Hemlock, original bearing tree, bearing N66°W, 44.9 feet, now missing.

cc: Mr. Zane Bennet, C.O.R.
Glide Ranger Station
U.S. Forest Service
Glide, Oregon
(re: USFS Timber Bench Road Survey)

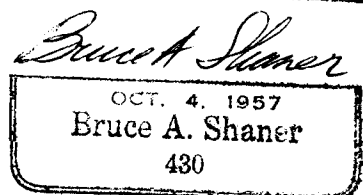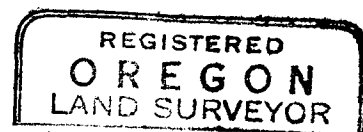

O.K.
J.W.B.

C. S. File No. 55/66