

RESTORED CORNER FOR STATE OF OREGON--DEPARTMENT OF FORESTRY

Closing corner common to Sections 6 & 7, Township
23 South, Range 9 West, Willamette Meridian, Douglas
County, Oregon.

ORIGINAL

Post (now missing) from which a:

6" Fir bears N 38½ E 16 lks.; now 17", exposed scribe C.
30" Fir bears S 24 E 133 lks.; now destroyed by road, portions
of the stump still in road berm.
Ridge, course S 50 W, bears South 2.08 chs.; in place.

RESTORATION by Arthur R. Evans, February 1952.

4" x 4" x 36" Fir Stake (found in place) from which a:

8" Fir bears S 42 E 28.1 ft.; now 9" Fir in place, face pitched
over.

RESTORED


Set 1½" x 36" galvanized iron pipe with 3" bronze cap marked "OREGON
STATE BOARD OF FORESTRY T 23S S1 S6 S7 CC R10W R9W 1967 RS 359",
34 inches in ground, in place of Evans post, in mound of rock,
and from which a:

24" Fir bears N 71 E 20.0 ft. to face; scribed T23S R9W S6 CC RT
RS 359.

Set 4" x 4" x 72" white painted Cedar post 1 ft. West of corner pipe.
Oregon State Forestry Department metal location poster on 24" Fir
N 39 W 9.5 ft.

Dated October 26, 1967

Restored by ED Kucera under my direction
E. D. Kucera, Transitman

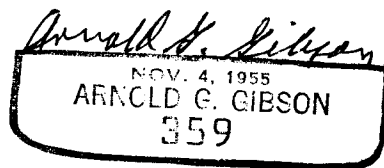

Present and witnessed by D. Smith
G. Gresham

48
50
11/26-32

100600 - 7239
700634 - 723-10

CS 55/60-1