

RESTORED CORNER FOR STATE OF OREGON--DEPARTMENT OF FORESTRY

One Quarter corner for Section 6 (Southside), Township
23 South, Range 9 West, Willamette Meridian, Douglas
County, Oregon.

ORIGINAL

Post (now missing) from which a:

60" Fir bears N $2\frac{1}{2}$ W 134 lks.; now 80" Fir, exposed scribe 1.
30" Fir bears S 50 E 61 lks.; now 3 ft. high stub, rotted.

RESTORED


Set $1\frac{1}{2}$ " x 36" galvanized iron pipe with 3" bronze cap marked "OREGON
STATE BOARD OF FORESTRY 1/4 S6 1967 RS 359", 33 inches in ground,
and from which a:

14" Fir bears N $1\frac{1}{4}$ W 50.5 ft. to face; scribed 1/4 S6 BT RS 359.
24" Fir bears N $40\frac{1}{4}$ E 52.4 ft. to face; scribed 1/4 S6 BT.

Set 4" x 4" x 72" white painted Cedar post 1 ft. SE of corner pipe.
Oregon State Forestry Department metal location poster on 12" Alder S61W
7.4.

Dated October 26, 1967.

Restored by *E. D. Kucera* under my direction
E. D. Kucera, Transitman

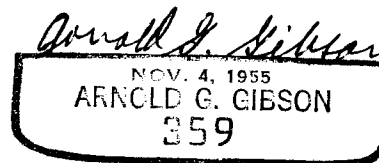

Present & witnessed by D. Smith
G. Gresham