

RESTORED CORNER FOR STATE OF OREGON—DEPARTMENT OF FORESTRY

One Quarter corner for Section 7, Township 23 South,
Range 9 West, Willamette Meridian, Douglas County,
Oregon.

ORIGINAL

Post (now missing) from which a:

- 8" Hemlock bears S 63 E 35 lks.; now a 22" windfall, face exposed, scribes 4 S 7 visible.
- 72" Fir bears N 70 W 49 lks.; now a 96" school marm, face closed, axe work visible in bark.

RESTORED


Set 1½"x36" galvanized iron pipe with 3" bronze cap marked "OREGON STATE BOARD OF FORESTRY 1/4 S7 1967 RS 359", 34 inches in ground, and from which a:

12" Hemlock bears S 29 W 23.5 ft to face; scribed 1/4 S7 BT RS 359.

Set 4" x 4" x 72" white painted Cedar post 1 ft. NW of corner pipe. Oregon State Forestry Department metal location poster on the 96" original BT.

Dated October 26, 1967.

Restored by E. D. Kucera under my direction.
E. D. Kucera, Transitman

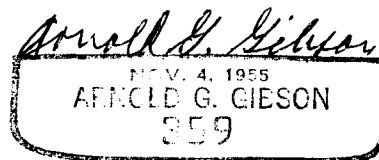

Present and witnessed by D. Smith
W. Cook