

RESTORED CORNER FOR STATE OF OREGON—DEPARTMENT OF FORESTRY

Section corner common to Sections 5 and 6, Township
23 South, Range 9 West, Willamette Meridian, Douglas
County, Oregon.

ORIGINAL

Post (now missing, found original lines blazes North) from which a:

- 14" Hemlock bears N 87 E 58 lks.; now a rotted windfall.
- 24" Hemlock bears S 65 E 80 lks.; now a rotted windfall.
- 48" Fir bears S 82 W 138 lks.; now 72" with face overgrown.
- 48" Hemlock bears N 72 W 84 lks.; now a 48" rotted stump,
remains of original axework around face.
- Found 32" Hemlock bears S 77½ W 33.9 ft. with scribes T23S,
R9W S5 BT facing SW (68 years overgrowth.)
- Stream, 1 lk., course N 10 W, bears North 523 lks.; now in place.

SURVEY by Oscar Thiel (1899) reported destroying SE and SW BTs.

- Stream, 3 lks, course N 60 W, East 425 lks.; now in place.
- North 1/4 cor. 7 bears N 89 - 45W 725 lks.; now in place.
- County Road bears N 89 - 45W 210 lks.; remains now in place.

RESTORED


Set 1½" x 36" galvanized iron pipe with 3" bronze cap marked "OREGON
STATE BOARD OF FORESTRY T23S R9W S6 S5 1967 RS 359", 34 inches in
ground, in mound of rock, and from which a:

- 20" Hemlock bears N 67 E 41.6 ft. to face; scribed T23S R9W S5 BT.
- 24" Hemlock bears N 54 W 45.4 ft. to face; scribed T23S R9W S6 BT
RS 359.

Set 4" x 4" x 72" white painted Cedar post 1 ft. NW of corner pipe.
Oregon State Forestry Department metal location poster on the 20" Hem-
lock BT.

Dated October 26, 1967

Restored by *ED Kucera*
E. D. Kucera, Transitman under my direction

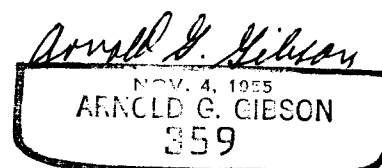

Present and witnessed by G. Gresham
C. Reinecker

#46

200600

C.S. File No. 55/68-4