

RESTORED CORNER FOR STATE OF OREGON--DEPARTMENT OF FORESTRY

One Quarter corner common to Sections 5 and 6, Township  
23 South, Range 9 West, Willamette Meridian, Douglas  
County, Oregon.

ORIGINAL

Post (now missing) from which a:

48" Fir bears N 65 E 46 lks.; now 48" Fir, orig bark scribes  
1/4 S BT visible.  
48" Fir bears S 80 W 36 lks.; now 60" windfall.

RESTORED


Set 1 1/2" x 36" galvanized iron pipe with 3" bronze cap marked "OREGON  
STATE BOARD OF FORESTRY 1/4 S6 S5 1967 RS 359" 3/4 inches in ground,  
and from which a:

14" Hemlock bears N 16 W 18.0 ft. to face; scribed 1/4 S6 BT  
RS 359.  
13" Hemlock bears S 86 E 26.0 ft. to face; scribed 1/4 S5 BT.

Set 4" x 4" x 72" white painted Cedar post 1.1 ft. South of corner pipe.  
Oregon State Forestry Department metal location poster on the 14" BT.

Dated October 26, 1967.

Restored by *E. D. Kucera* under my direction  
E. D. Kucera, Transitman

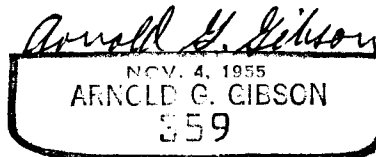

Present and witnessed by D. Fitch  
G. Gresham  
P. Buchmeier