

RESTORED CORNER FOR STATE OF OREGON—DEPARTMENT OF FORESTRY

One quarter corner common to Sections 31 and 6, Township 22 and 23 South, Range 9 West, Willamette Meridian, Douglas County, Oregon.

ORIGINAL

Post (now missing) from which a:

20" Fir bears North 18 lks.; now 26", face opened, knife scribes 4S visible at correct age.

24" Fir bears South 23 lks.; now 28" snag, knife scribes 1/ - S BT visible at correct age.

Creek, course North, bears East 325 lks.; now in place.

RESTORED


Set 1½" x 36" galvanized iron pipe with 3" bronze cap marked "OREGON STATE BOARD OF FORESTRY 1/4 S31 S6 1967 RS 359", 30 inches in ground, and from which a:

20" Hemlock bears S 69½ W 42.2 ft. to face; scribed 1/4 S6 BT RS359.

Set 4" x 4" x 72" white painted Cedar post 1.2 ft. South of corner pipe.

Dated November 27, 1967.

Restored by E. D. Kucera / E. D. Kucera, Transitman / under my direction

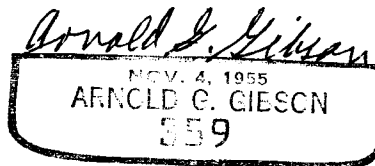

Present and witnessed by D. Smith  
G. Gresham