

RESTORED CORNER FOR STATE OF OREGON--DEPARTMENT OF FORESTRY

Township corner common to Sections 31 and 36, Township 22 South, Range 9 and 10 West, Willamette Meridian, Douglas County, Oregon.

ORIGINAL

Stone 6 x 14x16" in 4' x 2' mound of stone (found in place) from which a:

Ridgetop, NW and SE, bears North 300 lks.; now in place.
Ridgetop, NW and SE, bears East 300 lks .; now in place.

RESTORED

Set 1 1/2" x 36" galvanized iron pipe with 3" bronze cap marked "OREGON STATE BOARD OF FORESTRY T22S R10W R9W S36 S31 S1 T23S R10W 1967 RS 359," 30 inches in ground, alongside corner stone in mound of rock, and from which a:


17" Fir bears N 73 1/2 E 20.9 ft. to face; scribed T22S R9W S31 BT RS 359.

27" Fir bears N 21 W 24.5 ft. to face; scribed T22S R10W S36 BT.

Set 4" x 4" x 72" white painted Cedar post 1.6 ft. West of corner pipe. Oregon State Forestry Department metal location poster on the 27" Fir BT.

Dated October 26, 1967.

Restored by *G. Gresham* under my direction.
G. Gresham, Transitman

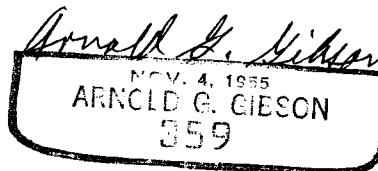

Present and witnessed by R. Ball
D. Fitch
P. Buchmeier

T 22-9 100 100
T 22-10 700 100
T 23-10 654 700 ?