


Dog Mt
 New Witness trees for
 1/4 Cor. between Sections 5 & 6
 T26S, R2E WM;

Dog Mountain Sale.



Road destroyed
 old Bearing Trees
 R.C.G.

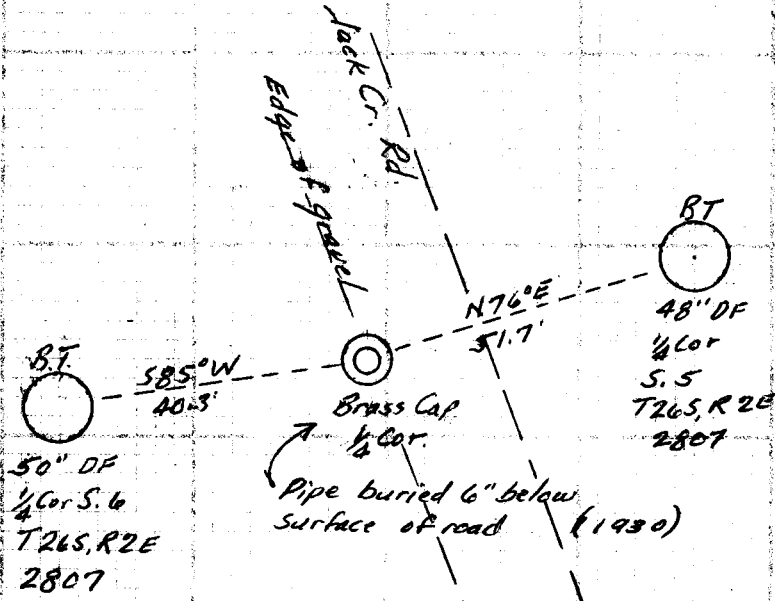

Richard C. Graw
 August, 1966

17 o.k. J.W.B.

C. S. File No. 55/71