


COUNTY SURVEYORS FILE DATA
DO NOT REMOVE FROM OFFICE

SURVEY FOR DEED DESCRIPTION
IN SEC. 26, T.27, R.7W.W.M.
SURVEYED FOR LES BLACK REALTY
by BRUCE R. ROGERS
MAY 2, 1968
1" = 100'

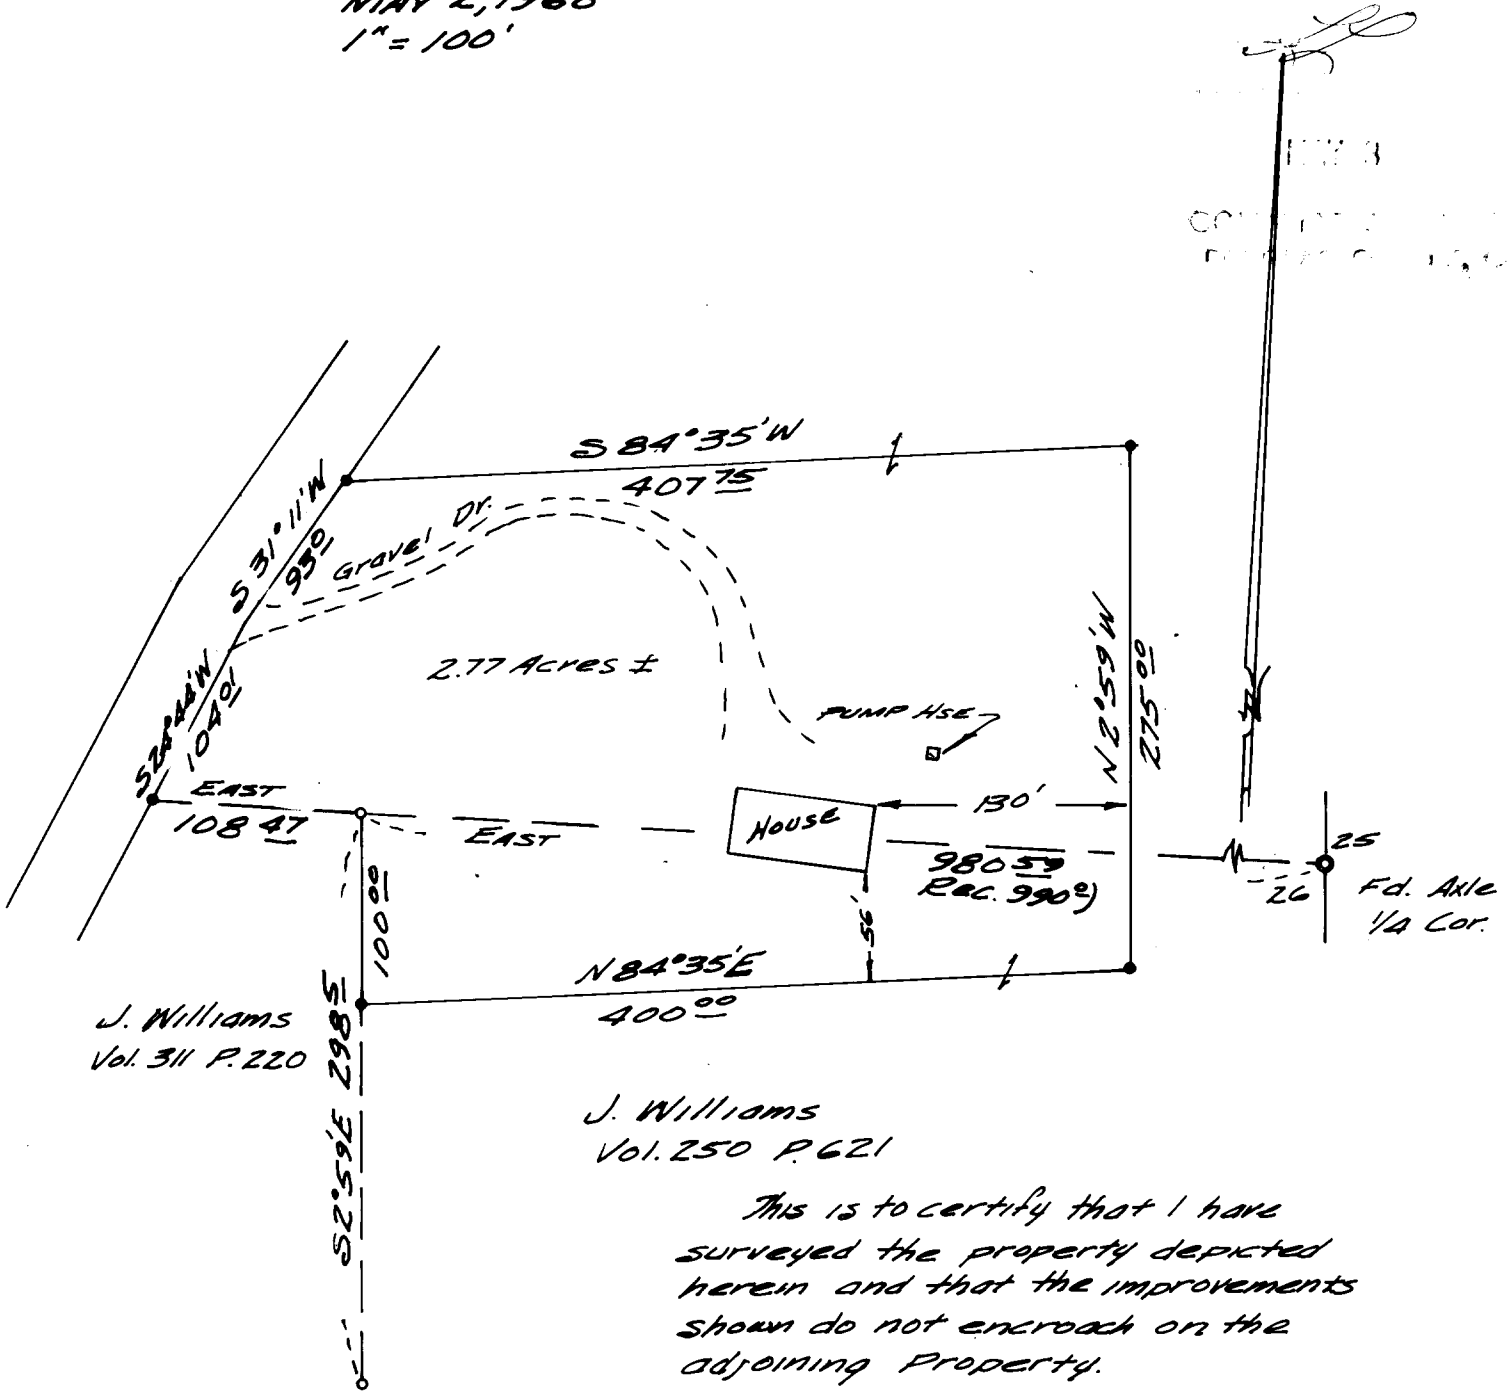

J. Williams
Vol. 311 P. 220

J. Williams
Vol. 250 P. 621

This is to certify that I have surveyed the property depicted herein and that the improvements shown do not encroach on the adjoining Property.

- o Fd. 1" Iron Bolt
- o Set 5/8" Iron Rod

REGISTERED
OREGON
LAND SURVEYOR

Bruce R. Rogers

JULY 10, 1964
BRUCE R. ROGERS
660

COUNTY SURVEYORS FILE DATA
DO NOT REMOVE FROM OFFICE