


U. S. F. S.
SW 1/4, Sec. 19

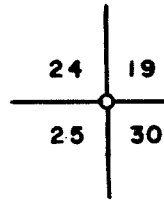

S89°37'W, 2658.68

(record S89°59'W, 2642.0)

NW 1/4, Sec. 30
MARTIN BROS.

**COUNTY SURVEYORS FILE DATA
DO NOT REMOVE FROM OFFICE**

Section Corner common to Sections 19 & 30, T28S, R2W,
& Sections 24 & 25, T28S, R3W, I found a Brass Cap set by
Douglas County Surveyor in 1962 from which a ;
28" Hemlock, original BT, now blown down, bears N29°E, 34.3 ft..
30" Fir BT, bearing S60°E, 15.8 feet, now missing.
36" D. Fir, original BT, bears S25°W, 18.0 ft.(orig. record 31.0 ft.).
36" Hemlock, original BT, scribes visible, bears N48°W, 15.8 ft..
36" Hemlock BT marked by County bears S14°E, 23.4 ft..
50" D. Fir BT, I scribed "S19 T28S R2W BT", bears
N53°E, 59.1 feet.


1/4 Section Corner common to Sections 19 & 30, T28S, R2W,
W.M., I found a badly decayed 4" square x 36" long Yew Post with
Scribe "4" and portions of other scribes visible; I replaced this orig-
inal corner post with a Brass Cap which I marked "T28S, R2W
1/4 S19 & S30, 1968, ORE, 4906" and from which Brass Cap a :
7" Hemlock, original BT, badly chopped, no scribes visible,
bears N5°E, 11.2 feet.
8" Hemlock, original BT, bearing S78°E, 5.3 ft., now missing.
44" D. Fir, I scribed "1/4 S S19 T28S R2W BT",
bears N7°W, 18.0 feet.
10" Yew BT, I scribed "1/4 S S30 T28S R2W BT",
bears S34°W, 24.5 feet.
The corner is at junction of very old blazed line running E-W
and one running South. Original line calls of ravine at 3 chains E
and ridge at 4 chains E are good,



Bearing based on
Solar Observation.

Scale: 1" = 300 feet

Note: Property Line marked with Steel
fence posts & USFS boundary signs,

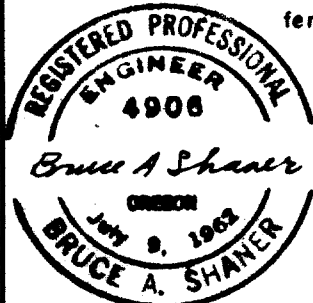

FILED
RECEIVED

MAY 13 1968

COUNTY SURVEYOR
DOUGLAS COUNTY, ORE.

PROPERTY LINE SURVEY
FOR UMPQUA NATIONAL FOREST
IN THE SW 1/4 OF SEC. 19, T28S, R2W, W.M.
May 13, 1968
Bruce A. Shaner, Engineer


55/74A

CERTIFIED RECORD OF LAND CORNER MONUMENTATION

COUNTY SURVEYORS FILE DATA

History of original corner establishment:

DO NOT REMOVE FROM OFFICE

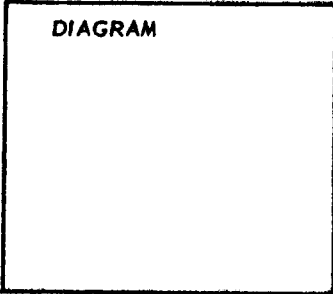

Quarter Section Corner common to Sections 19 & 30, T28S, R2W, W. M., Douglas County, Oregon:

Original corner set by U. S. Government survey in 1909, and described as follows:

Set Yew Post, 3 feet long, 4" square, 24" in the ground for 1/4 Section Corner, marked "1/4 S 19" on N and "30" on S face, from which:

- A hemlock, 8" diameter, bears S78°E, 8 links distant, marked "1/4 S30 BT"
- A hemlock, 5" diameter, bears N5°E, 17 links distant, marked "1/4 S19 BT"

Description of corner evidence found:

I found a badly decayed 4" square x 36" long Yew Post with scribe "4" and portions of other scribes visible; from which post a:

7" hem lock, original BT, badly chopped, no scribes visible, bears N5°E, 11.2 ft..

8" hemlock, original BT, Bearing S78°E, 5.3 feet, now missing.

The corner is at junction of very old blazed line running E-W and one running South. Original line calls of ravine at 3 chains E and ridge at 4 chains E are good.


Description of monument and accessories I established to perpetuate the original location of this corner

At the location of the original corner post I placed a Brass Cap which I marked "T28S, R2W, 1/4 S, S19 & S30, 1968, ORE 4906", and from which Brass Cap a:

7" hemlock, original BT, badly chopped, no scribes visible, bears N5°E, 11.2 Ft..

44" D. Fir, I scribed "1/4 S S19 T28S R2W BT", bears N7°W, 18.0 feet.

10" Yew BT, I scribed "1/4 S S30 T28S R2W BT", bears S34°W, 24.5 feet..

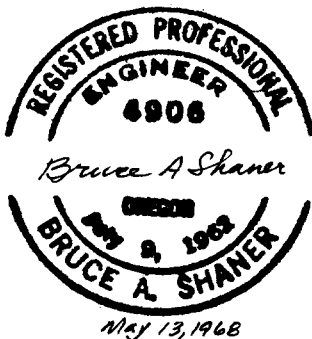

Office of County Surveyor County of Douglas
State of Oregon , I hereby certify that the within instrument was filed in this office
for record on the 13 day of MAY 1968, at 10 o'clock A.M., (signed)

James W. Ryan by
(COUNTY OFFICIAL) (DEPUTY)

COUNTY SURVEYORS FILE DATA
DO NOT REMOVE FROM OFFICE
CERTIFIED RECORD OF LAND CORNER MONUMENTATION

History of original corner establishment:


Quarter Section Corner common to Sections 30 & 31, T28S, R2W, W.M., Douglas County, Oregon:

Original corner set by U.S. Government survey in 1909 and described as follows:

Set Lava Stone, 8x8x12 inches, 8 inches in the ground for 1/4 Section Corner, marked "1/4" on N face, from which:

A Fir, 5 inches diameter, bears S6°E, 17 links distant, marked "1/4 S 31 BT"

A laurel, 5 in. diam., bears N50°E, 30 links dist., marked "1/4 S 30 BT".

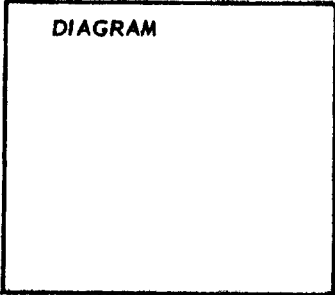

Description of corner evidence found:

I found a 8x8x12 inch stone, no "1/4" visible, from which stone a:

10" diameter Douglas Fir, an original BT with scribes "S 31 BT" visible, bears S6°E, 11.2 feet.

10" diameter Madrone, original Laurel BT, face badly rotted but with portions of scribes "1/4" visible, bears N64°E (record was N50°E) a distance of 19.8 feet.

Description of monument and accessories established to perpetuate the original location of this corner


At the original corner stone I placed a Brass Cap marked "T28S, R2W, 1/4 S30 & S31, 1968, ORE 4906", and from which Brass Cap a:

10" Diam. D. Fir, an original BT with scribes "S 31 BT" visible, bears S6°E, 11.2 feet.

10"Diam. Madrone, original Laurel BT, face badly rotted with portions of scribes "1/4" visible, bears N64°E a distance of 19.8 feet.

26" Sugar Pine, I scribed "1/4 S S30 T28S R2W BT", bears N88°W, a distance of 10.4 feet.

This corner is approximately 7 chains East of a logging road.

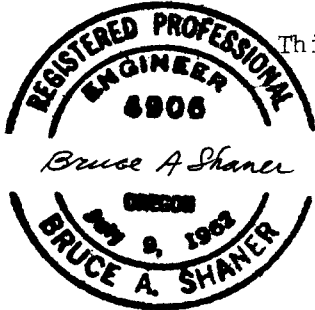

May 13, 1968

Office of County Surveyor County of Douglas
State of Oregon I hereby certify that the within instrument was filed in this office
for record on the 13 day of MAY 1968, at 10 o'clock A.M., (signed)
..... by
(COUNTY OFFICIAL) (DEPUTY)

CERTIFIED RECORD OF LAND CORNER MONUMENTATION

COUNTY SURVEYORS FILE DATA

DO NOT REMOVE FROM OFFICE

History of original corner establishment:


Quarter Section Corner common to Sections 30 & 29, T28S, R2W, W.M., Douglas County, Oregon:

Original corner set by U.S. Government survey in 1909 and described as follows:

Set fir stake, 3 feet long, 4 " square, 24 inches in the ground, marked "1/4 S 30" on W and "29" on E face, from which;

A pine, 8 inches diameter, bears S55°W, 14 links, marked "1/4 S 30 BT".

A pine, 7 inches diameter, bears N71°E, 45 links dist., marked "1/4 S 29 BT"

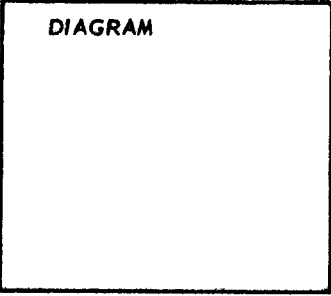

Description of corner evidence found:

Original corner stake was missing, but from the spot it occupied a;

10" Pine, original BT with scribes visible, now blown down and rotting, bears S55°W a distance of 9.2 feet;

16" White Pine, original BT with scribes visible, bears N71°E a distance of 29.7 feet;

Description of monument and accessories established to perpetuate the original location of this corner


/marked "T28S R2W 1/4 S30 & S29, 1968, ORE 4906"

I set a Brass Cap/at position of original corner stake from which Brass Cap a:

10" Pine, original BT with scribes visible, now blown down and rotting, bears S55°W a distance of 9.2 feet.

16" White Pine, original BT with scribes visible, bears N71°E a distance of 29.7 feet.

10" D. Fir, I scribed "1/4 S S30 T28S R2W BT", bears S26°W a distance of 22.0 feet.

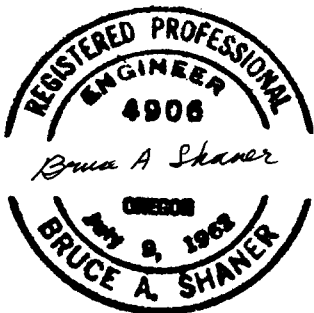

May 13, 1968

Office of County Surveyor County of Douglas
State of Oregon

, I hereby certify that the within instrument was filed in this office for record on the 13 day of MAY, 1968, at 12 o'clock A.M., (signed)

James W. Rymer (COUNTY OFFICIAL) by (DEPUTY)