


SURVEY FOR DEED DESCRIPTION
 IN SEC. 12, T27S, R6W1W
 SURVEYED FOR WILL B. BALDRIDGE
 BY BRUCE R. ROGERS
 JULY 1, 1968
 1" = 100'

FILED
 RECEIVED
 JUL 17 1968
 COUNTY SURVEYOR
 CLATSOP COUNTY, OREGON

COUNTY SURVEYORS FILE DATA
 DO NOT REMOVE FROM OFFICE

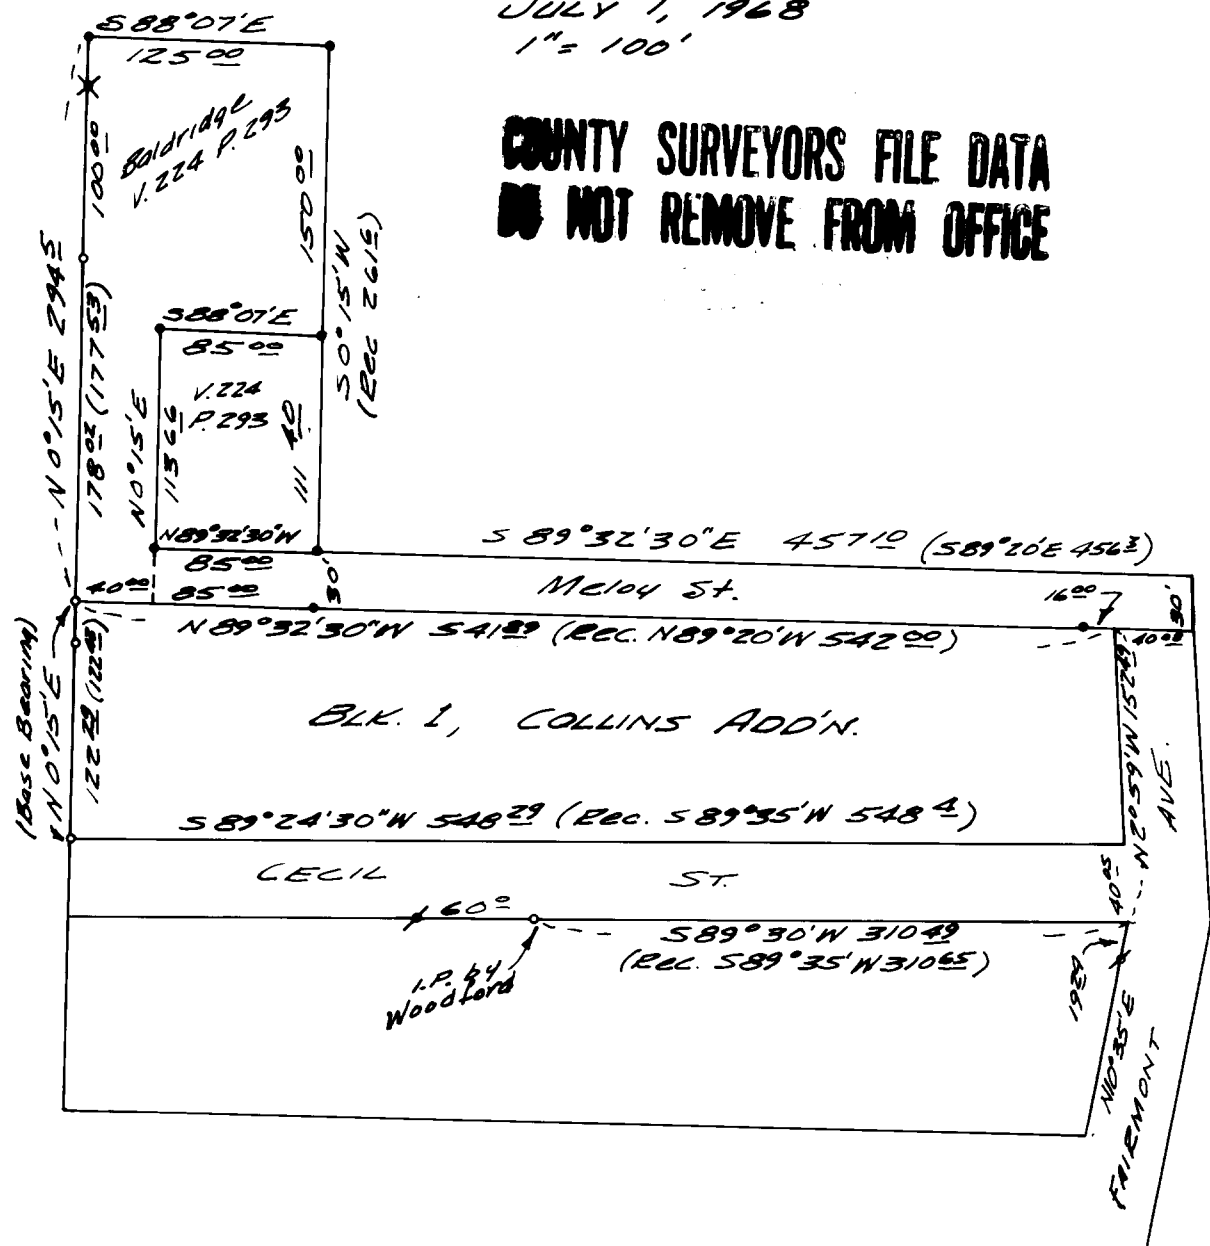

- o Fd. Iron Pipe
- o Fd. Iron Rod
- o Fd. angle Iron
- o set 5/8" Iron Rod.

REGISTERED
 OREGON
 LAND SURVEYOR

Bruce R. Rogers

JULY 10, 1964
 BRUCE R. ROGERS
 660