


CERTIFIED RECORD OF LAND CORNER MONUMENTATION

History of original corner establishment:

Corner established 1857 General Land Office
Contract survey by Hathorn

Original survey states Set Woodfn Post for corner
a fir 36" diam. bears N.10°E. 8 lks
a fir 15" diam. bears N.15° W. 34 lks.

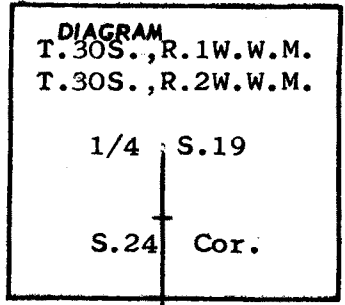


Description of corner evidence found:

None

Description of monument and accessories I established to perpetuate the original location of this corner

I set a 2"X30" I.P. with brass cap

I stamped the disc.

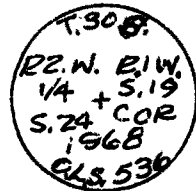

From the pipe monument the new bearing trees are.
a 16" fir bears N.57°E. 19.4 ft. scribed 1/4S.19 T.30S. R.1W.
a 20" fir bears West 3.5 ft. scribed 1/4 S. 24 T.30S. R.2W.
I also placed USFS bearing tree signs on both trees breast high and facing the pipe monument

Office of.....Surveyor..... County of...Douglas.....
State of...Oregon....., I hereby certify that the within instrument was filed in this office
for record on the 12 day of July....., 1968, at 4 o'clock P.m., (signed)

James W. Ryan (COUNTY OFFICIAL) by (DEPUTY)

700340
#105 T30-2W
#106 100340