

CERTIFIED RECORD OF LAND CORNER MONUMENTATION

History of original corner establishment:

Corner established in 1857 by General Land Office.
Contract survey by Hathorn.


Original survey states:

Set wooden post, 1/4 Section corner to S.30 & S.31.

From which:

A fir, 40 ins. diam. bears N.80°W., 15 lks.

A fir, 6 ins. diam. bears S.50°W., 26 lks.

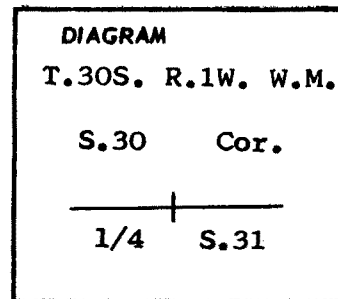


Description of corner evidence found:

None

Description of monument and accessories I established to perpetuate the original location of this corner

I set a 2" x 30" Iron Pipe with brass cap.
I stamped the disc.

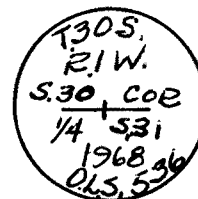

From the pipe monument, the new bearing trees are:

a 4" fir bears N.22°E. 7.4 ft. scribed T.30S. R.1W. S 30 B.T.

a 8" fir bears S.48°W. 27.6 ft. scribed T. 30S.R.1W. S 31 B.T.

I also placed U.S.F.S. bearing tree signs on both trees, breast high and facing the pipe monument.

Office of Surveyor County of Douglas
 State of Oregon, I hereby certify that the within instrument was filed in this office
 for record on the 12 day of July, 19 68, at 4 o'clock P.m., (signed)
James W. Ryan by _____
 (COUNTY OFFICIAL) (DEPUTY)