


CERTIFIED RECORD OF LAND CORNER MONUMENTATION

History of original corner establishment:

None

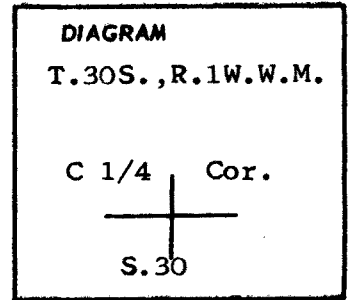

Description of corner evidence found:

None

Description of monument and accessories I established to perpetuate the original location of this corner

I set a 2"X30" I.P. with brass cap.

I stamped the disc.



From the pipe monument the new bearing trees are:

a 10" cedar bears S.74°W. 40.0 ft.scribed C 1/4 S.30 BT

a 5" cedar bears S.54° E. 38.5 ft. scribed C 1/4 S.30 BT

I also placed USFS bearing tree signs on both trees, breast high and facing the pipe monument.

Office of Surveyor County of Douglas
 State of Oregon, I hereby certify that the within instrument was filed in this office
 for record on the 12 day of July, 1968, at 4 o'clock P.m., (signed)
John W. Byrum by _____
 (COUNTY OFFICIAL) (DEPUTY)