


CERTIFIED RECORD OF LAND CORNER MONUMENTATION

History of original corner establishment:

Corner established in 1857 by General Land Office Contract survey by Hathorn

Original survey states:

Set wooden post for corner from which a hemlock 10 ins. diam., bears S.24°E. 51ks a maple 10 ins. diam., bears N.40°E. 40lks

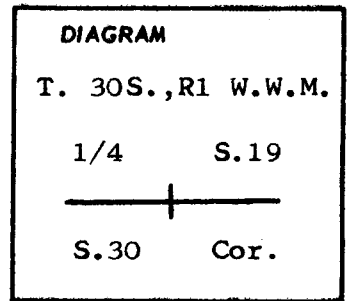

Description of corner evidence found:

None

Description of monument and accessories I established to perpetuate the original location of this corner

I set a 2"X30" I.P. with brass cap

I stamped the Disc. _____



From the pipe monument the new bearing trees are. a 14" madrone bears N.21°E. 27.3 ft. scribed 1/4 S.19 T.30S.R1W. BT a 14" pine bears S.11°E. 17.0 ft. scribed 1/4 S.30 T.30S.,R.1W. BT. I also placed USFS bearing tree signs on both trees, breast high and facing the pipe monument.

Office of Surveyor _____ County of Douglas _____
 State of Oregon _____, I hereby certify that the within instrument was filed in this office
 for record on the 12 day of July _____, 1968, at 4 o'clock P.m., (signed)
 _____ by _____
 (COUNTY OFFICIAL) (DEPUTY)