

CERTIFIED RECORD OF LAND CORNER MONUMENTATION


History of original corner establishment:

Corner established 1857 by General Land Office  
Contract survey by Hathorn

Original survey states:

Set wooden post. Corner to Sections 19,30,24, and 25  
from which:

- A fir, 50 ins. diam, bears S.5°W., 25 lks.
- A fir, 18 ins. diam, bears S.55°E., 17 lks.
- A fir, 20 ins. diam. bears N.40°W., 19 lks.
- A fir, 10 ins. diam. bears N.70°E., 48 lks.

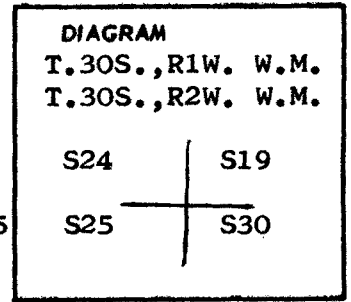


Description of corner evidence found:

None

Description of monument and accessories I established to perpetuate the original location of this corner

I set a 2" x 30" Iron Pipe with brass cap.

I stamped the disc.

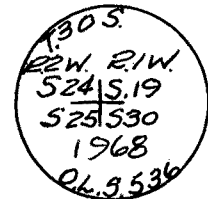

From the pipe monument the new bearing trees are:

- 6" Chinquapin 23.5' bears S.36W. Scribed T30S. R2W. W.M. S25. B.T.
- 6" white fir 46.0' bears S.17E. Scribed T30S. R1W. S.30, B.T.
- 24" Douglas fir 22.4' bears N56E. Scribed T30S. R1W. S.19, B.T.
- 8" Maple 6.2' bears N20W. Scribed T30S. R2W. S.24, B.T.

I also placed the U.S.F.S. bearing tree signs on all trees breast high, and facing the pipe monument.

Office of Surveyor County of Douglas  
 State of Oregon, I hereby certify that the within instrument was filed in this office  
 for record on the 12 day of July, 1968, at 4 o'clock P.m., (signed)  
Jamie W. Ryan by \_\_\_\_\_  
 (COUNTY OFFICIAL) (DEPUTY)

700300  
 151-T30-100  
 108 100300