


CERTIFIED RECORD OF LAND CORNER MONUMENTATION

History of original corner establishment:

None.

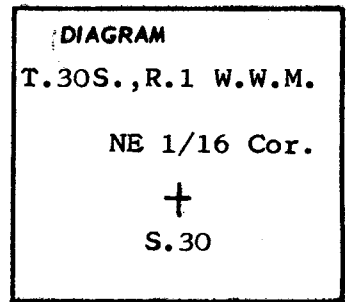

Description of corner evidence found:

None

Description of monument and accessories I established to perpetuate the original location of this corner

I set a 2"X30" I.P. with brass cap.

I stamped the disc.



From the pipe monument the new bearing trees are:
 a 10" fir bears N.10°W. 30.9 ft. scribed NE 1/16 S. 30 BT
 a 4" fir bears S.7°W. 45.2 ft. scribed NE 1/16 S.30 BT.
 I also placed USFS bearing tree signs on both trees breast high and facing the pipe monument.

Office of Surveyor County of Douglas
 State of Oregon, I hereby certify that the within instrument was filed in this office
 for record on the 12 day of July, 1968, at 4 o'clock P.m., (signed)
James W. Ryan by _____
 (COUNTY OFFICIAL) (DEPUTY)