


CERTIFIED RECORD OF LAND CORNER MONUMENTATION

History of original corner establishment:

None

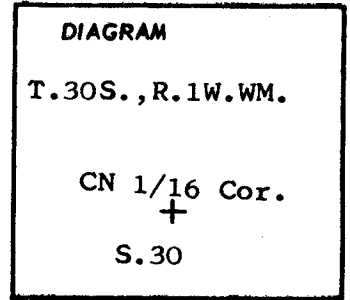


Description of corner evidence found:

None

Description of monument and accessories I established to perpetuate the original location of this corner

I set a 2"X30" I.P. with brass cap.

I stamped the disc. →

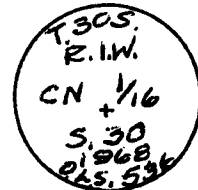

From the pipe monument the new bearing trees are:
a 4" madrone bears N.69 1/2°W. 35.6 ft. scribed CN 1/16 S.30 BT
a 20" cedar bears N.9°W. 74.6 ft. scribed CN 1/16 S.30 BT.
I also placed USFS bearing tree signs on both trees, breast high and facing the pipe monument.

Office of Surveyor County of Douglas
 State of Oregon, I hereby certify that the within instrument was filed in this office
 for record on the 12 day of July; 19 68 at 4 o'clock Pm., (signed)
James W. Dymon by _____
 (COUNTY OFFICIAL) (DEPUTY)