


CERTIFIED RECORD OF LAND CORNER MONUMENTATION

History of original corner establishment:

None

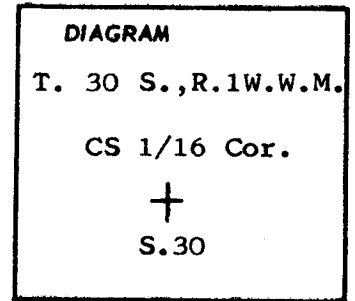

Description of corner evidence found:

None

Description of monument and accessories I established to perpetuate the original location of this corner

I set a 2"X30" I.P. with brass cap.

I stamped the disc.



From the pipe monument the new bearing trees are:
a 6" pine bears S.33°W. 15.3 ft. scribed CS 1/16 S.30 BT
a 20" cedar bears N.75°E. 34.6 ft. scribed CS 1/16 S.30 BT
I also placed USFS bearing tree signs on both trees, breast high and facing the pipe monument.

Office of Surveyor County of Douglas
State of Oregon, I hereby certify that the within instrument was filed in this office
for record on the 12 day of July, 1968 at 4 o'clock Pm., (signed)
James W. Byrnes by _____
(COUNTY OFFICIAL) (DEPUTY)